


Map Barton Well 1

Sec. 23 Twp. 17 Range 11W

Disque Farm
Slick, Property & Lockhart Company

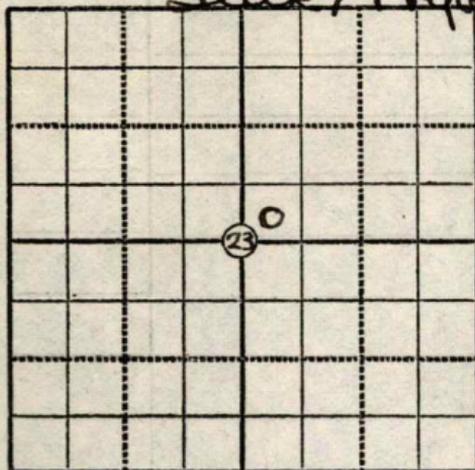

Date	
9/4/29	Tools
	M.O.
9/18	
9/25	Spud
10/2	

Date	
10/8	Rigging
10/16	Spud
23	310
	500
11/9	1285 3 1/2 BW 1180-90 top of salt 1180 697 15"
NOV 13 '29	
NOV 20 '29	
NOV 27 '29	SD
	1750 1/2 BW 1675-1685
	2135
DEC 18 '29	2345
DEC 23 '29	

23
17

Date

SD 3130

JAN 22 1930

ref 6" 3340

3342

3425 UR 6"

deepened 5' - 2' line

& 3' sand - 400' water

had 1500' water

3397-3400

HFW 3435

G+A 3458