


Ellsworth

Form 51-5M-1-30-38840

Map No. **KANSAS** Sec. *23* Twp. *17* R. *10th*

Well No. *1- E. H. Hickins* Farm
Click Bryon & Lockhart Company
& Darby

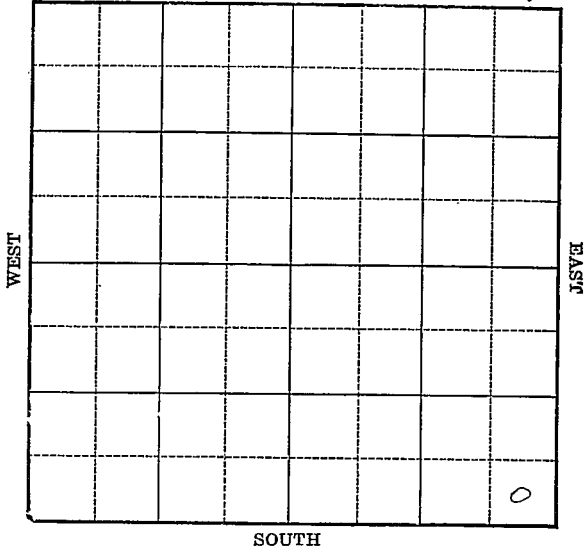

Location _____
Drilling Remarks _____

Rig Up _____
Drilling Remarks _____

RECORD

Cased _____ in. _____ ft.
Sand _____
Gas _____
Oil _____
Total Depth _____

PRODUCTION

1st 24 hrs. Nat. _____
1st 24 hrs. after shot _____
Gas _____ cu. ft.
Dry Hole _____
Abandoned _____

Map No. KANSAS Sec. 23 Twp 17 R. 10^w

Well No. 1- E.H. Heiken Farm


Sleck-Pryor-Lockhard Company
Parby

 Ft. from N. Line

330 Ft. from S. Line

330 Ft. from E. Line

 Ft. from W. Line

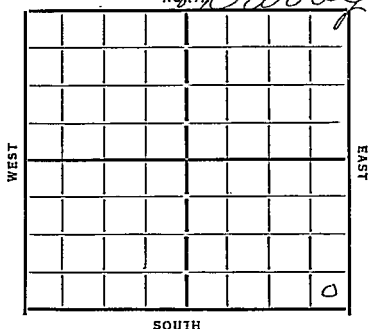

1932

Date	REPORT
12/7	Loc.
12/14	M.S.M.
12/21	Bldg rig
12/28	Rig up
1933	
1/4	20"-130
	Drlg 275'
1/11	20"-158
	1.5"-498
	Drlg 720'
1/18	13"-1210
	Drlg 1675'
1/25	10"-1830
	Est 100,000 ft gas 2145
	drlg 2415'
2/1	8"-2410
	HFV 2980-85
	show gas 2960-70
	Drlg 3000'
2/8	TID 3170 UIR 6"
	(over)

2/15 6"-3173
Top Cong 3195
" Chalk 3244
Oil 3251-54
TD 3262
1800 ft oil
swab 7 bbl per hour
for 4 hours

2/22- TD. 3262' Ang tubing
3/4 Pump to bbls. 9 hrs showed
water

3/8-6" 3173'- Sand 3244-3262' T.D.
Pump 3251-3254' Pump 65
bbls 24 hr

Completed

55 KANSAS

Ellsworth

W

Map No. Sec. 23 Twp. 17 R. 10

Well No. 1 E. A. Heiken

Slick, Gayer & Lockhart & Darby Company

Contractor

FIRST REPORTS

SECTION PLAT

			o

Ft. from N. Line

330 Ft. from S. Line

330 Ft. from E. Line

Ft. from W. Line

Location. ✓

Rig up

Drilling and Remarks:

RECORD

Cased in., ft.

Sand

Gas

Oil

Total Depth

PRODUCTION

1st 24 hrs. Nat.

1st 24 hrs. after shot

Gas Cu. Ft.

Dry Hole


Abandoned

Date

DEC 7 1932 CHAS. L. CHERWOOD

192

Scout

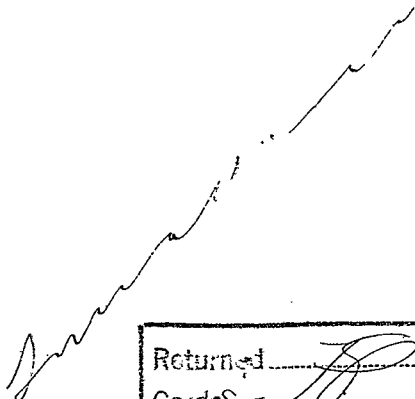

Returned	<i>[Signature]</i>
Cards	<i>[Signature]</i>
Tracing	<i>[Signature]</i>
France Map	<i>[X]</i>
Scarborough Map	<i>[X]</i>
Moody Map	<i>[X]</i>
Scarborough Map	<i>[X]</i>
Moody Map	<i>[X]</i>

Ellsworth

55 KANSAS Map No. Sec. 23 Twp. 17 R. 10 W

Well No. 1 E. H. Heiden "B"

Slick, Pryor, Lockhart & Darrow Company

Contractor

COMPLETED

SECTION PLAT

			o

Ft. from N. Line

330 Ft. from S. Line

330 Ft. from E. Line

Ft. from W. Line

Location

Rig up

Drilling and Remarks:

Pay 3251-54
 Pump 65 Bes
 24 Hens.

RECORD

Cased 6 in., 3173 ft.

Sand 3244-3262

Gas

Oil

Total Depth 3262

PRODUCTION

1st 24 hrs. Nat.

1st 24 hrs. after shot

Gas Cu. Ft.

Dry Hole

Abandoned

Date

MAR 8 1933 CHAS. L. SHERWOOD

192

Scout

Returned

Cards

Tracing

France Map

Scarborough Map

Moody Map

Scarborough Plat Book

Moody Plat Book

[Handwritten signatures and scribbles]