


KANSAS

Ellsworth

Section 23 Township 17 Range 10W

Well No. #1 Heiken

Company Derby Oil

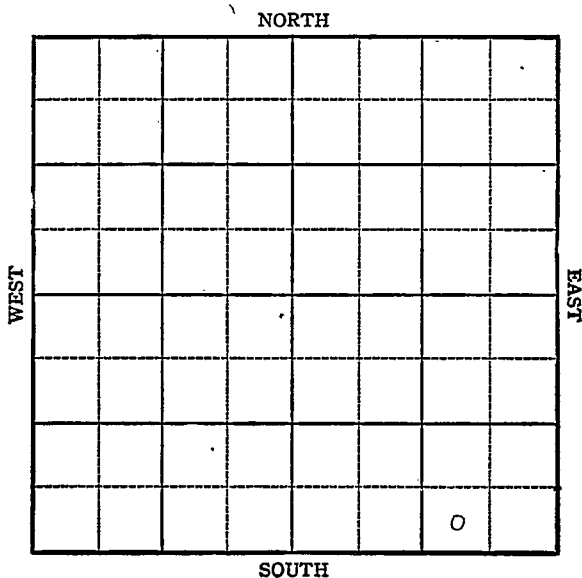

KANSAS

Ellsworth

Sec. 23 Twp. 17 R. 10W

Well No. #1, Heiken Farm

Derby Oil Company

Bloomer


NORTH

 Ft. from N. Line

330 Ft. from S. Line

990 Ft. from E. Line

 Ft. from W. Line

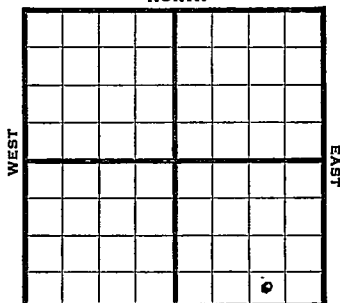

SOUTH

SW SE SE Elev. 1788

1944

R E P O R T

6/14 Location

6/21 Cellar

6/28 Rotary

7/12 Drlg 2780

7/19 Lans 2915

Arb 3254-61 TD

5" @ 3258 RUST

7/26 TD 3278 swb. 4 oil SW per hr 3hrs

8/9 Arb. 3254

5" @ 3258

Water

TD 3316

ABANDONED

KANSASPool Name BloomerMap No.)) Sec. 23 Twp. 17 R. 10WWell No. 1 HeikenDerby Oil

Company

FIRST REPORT

Contractor

SW SE SE

SECTION PLAT

 Ft. from N. Line330 Ft. from S. Line990 Ft. from E. Line Ft. from W. LineEllsworth CountyLocation XRig up

Drilling and Remarks:

RECORD

Cased in., ft.Sand Gas Oil Total Depth

PRODUCTION

1st 24 hrs. Nat. 1st 24 hrs. after shot Gas Cu. Ft.Dry Hole Abandoned

Date

JUN 14 1944 19S. J. LEWIS

Scout

Pool Name BloomerMap No. 5 ^{KANSAS} Sec. 23 Twp. 17 R. 10WWell No. 1 HeikenDerby Oil

Company

ABANDONED

Contractor

SW SE SE

SECTION PLAT

			0

Ft. from N. Line

330

Ft. from S. Line

990

Ft. from E. Line

Ft. from W. Line

Ellsworth County

Location _____

Rig up _____

Drilling and Remarks:

Cor 832545" 03258Water.

RECORD

Cased _____ in., _____ ft.

Sand _____

Gas _____

Oil _____

Total Depth 33 1/6

PRODUCTION

1st 24 hrs. Nat. _____

1st 24 hrs. after shot _____

Gas _____ Cu. Ft.

Dry Hole _____

Abandoned _____

Date

AUG 9 1944 19S. J. LEWIS Scout