

# KANSAS


Ellsworth

FORM 51 5M.10-41 PETROL

Section 23 Township 17 Range 10-W

Well No. #1 Stratmann

Company Atlantic Production

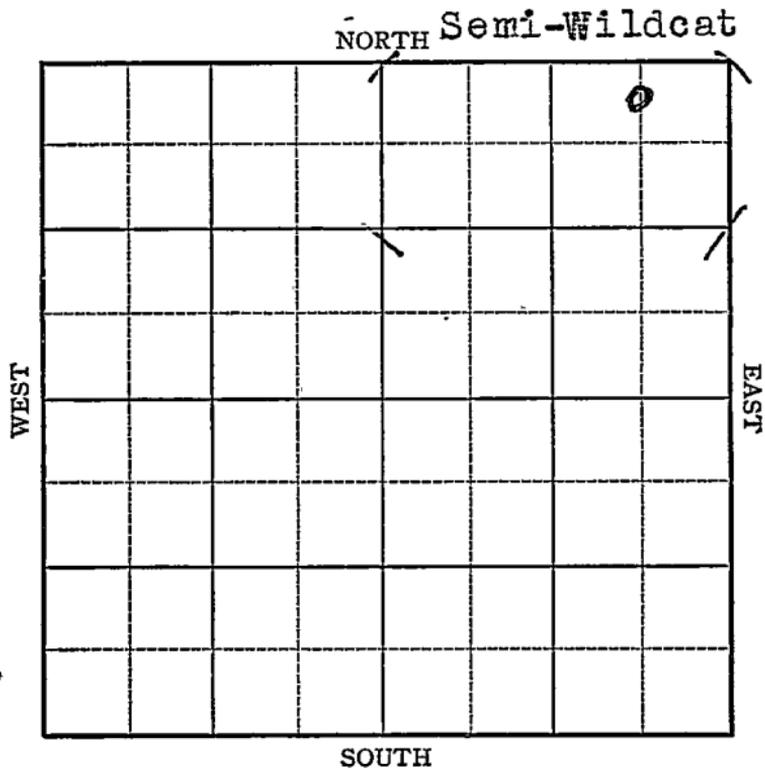

Sec. 23 Twp. 17 R. 10-W

Well No. #1 Stratmann Farm

Atlantic Production Company

(Semi-Wildcat)


330 Ft. from N. Line

         Ft. from S. Line

660 Ft. from E. Line

         Ft. from W. Line

Elev. 1769

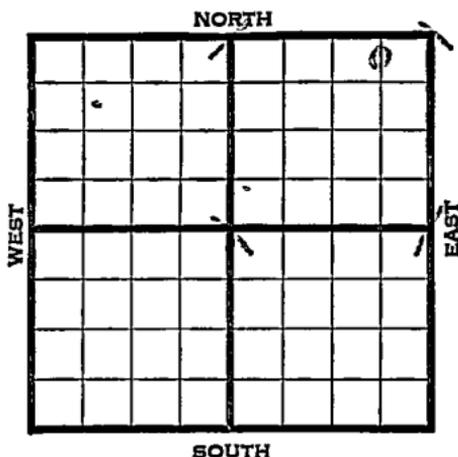

1942

REPORT

3/18

Derrick.

3/26

8" - 281' Drlg. 1680'

4/2

Drlg. 3150'

4/8

Lans. 2915' Cong. 3214'

Rev Arb. 3219' Arb. 3224'

T.D. 3235' Shot 4 qts. 3231-35' C.O.

4/15

T.D. 3239' 1000 acid. 85' oil 1 hour.

4/22

" " "

4/29

" " "

5/6

" " "

5/13

" " "

5/20

" " "

5/27

" " "

6/3

" " "

6/10

" " "

6/17

" " "

6/24

" " "

7/1

" " "

OVER

1942

7/8

Arb. 3224'

5" - 3224'

T.D. 3239'

Shot 4 qts. 3231-35'

1000 acid.

Potential 90 bbls., pump.

43. Gravity

**COMPLETED**

Ellsworth **KANSAS**Map No. 55 Sec. 23 Twp. 17 R. 10WWell No. 1 StratmannAtlantic Production Company**FIRST REPORT**

Contractor

C NL NE NE

330 Ft. from N. Line       Ft. from S. Line660 Ft. from E. Line       Ft. from W. Line

## SECTION PLAT

			o

SEMI-WILDCAT

Location \_\_\_\_\_

Rig up \_\_\_\_\_

Drilling and Remarks:

Derrick

## RECORD

Cased \_\_\_\_\_ in., \_\_\_\_\_ ft.

Sand \_\_\_\_\_

Gas \_\_\_\_\_

Oil \_\_\_\_\_

Total Depth \_\_\_\_\_

## PRODUCTION

1st 24 hrs. Nat. \_\_\_\_\_

1st 24 hrs. after shot \_\_\_\_\_

Gas \_\_\_\_\_ Cu. Ft.


Dry Hole \_\_\_\_\_

Abandoned \_\_\_\_\_

Date

MAR 1 8 1942 19

S. I. LEWIS Scout

 

- Misc Small Maps *MM*
- Cards *MM*
- Tracing *MM*
- France Map *MM*
- Scarborough Map *MM*
- Moody Map *MM*
- Geological Dept. \_\_\_\_\_
- Moody Flat Book \_\_\_\_\_



Misc. Small Map  
Cards  
Tracing  
France Map  
Scarborough Map  
Moody Map  
Geological Dept.  
Moody Plat Book

*Handwritten signature*