


Section 23 Township 17 Range 10WWell No. #1 Stratman (B)Company Eldorado Ref.

NORTH

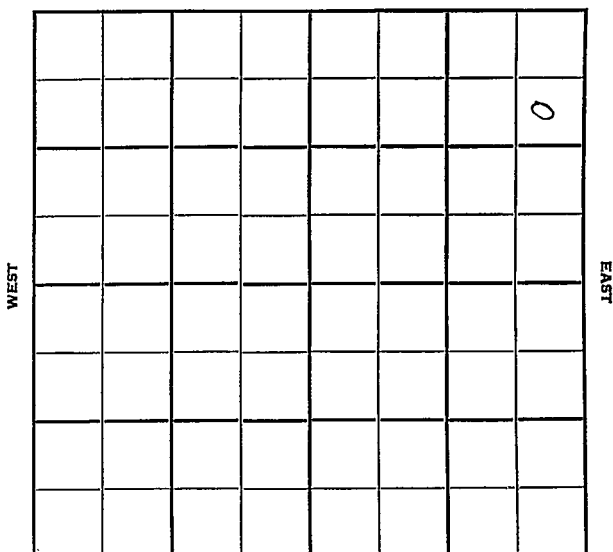

SOUTH

Ellsworth

KANSAS

Sec. 23 Twp. 17 R. 10W

Well No. #1 Stratman Farm

El Dorado Ref. Company

Contractor


990' Ft. from N. Line

_____ Ft. from S. Line

330' Ft. from E. Line

_____ Ft. from W. Line

SE NE NE

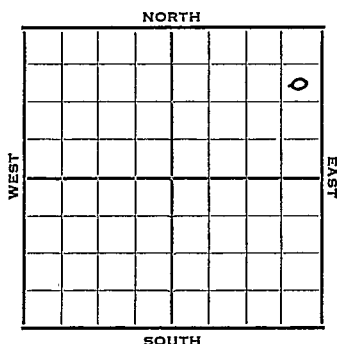

1952 Elev. 1792' REPORT

3/19 Spud 3-15-52
8" @ 278

WOC

3/25 Anhy 530 Heeb. 2792
Br Li 2895 Lans. 2905

Drlg. 3180'

4/1 Cong. 3232 Ero Arb. 3239
Arb. 3243 RTD 3246

5" @ 3244 MICT

4/9 Spud 3-15-52
D & A TD 3298'
8" @ 278' Anhy 530' Heeb 2792'
Br. lime 2895' Lans. 2905'
Cong. 3232' Re-Arb. 3239' Arb. 3243'

TD 3246' 5" @ 3244 DD 3256'

B/2 GOPH 2 hr. DD 3298'

B/2 bailers fluid $\frac{1}{2}$ hr. PB 3257'

500 A B/1 $\frac{1}{2}$ GOPH TD 3298'

D & A

ABANDONED

County Ellsworth State Kansas
 Sec. 23 (Blk.) 17 (Sur.) 10W Map No.

Operator Eldorado Ref.

Well No. 1 Farm Stratman

Elev. Location SE NE NE

FIRST REPORT

990 Ft. From N Line NE

330 Ft. From E Line Quarter

1st. Report MAR 19 1952

Completion

Remarks

Spudding Date 3-15-52

Drilg. Data

8" @ 278 WOC


J. G. McGEHEE

County Ellsworth State Kansas
 Sec. 23 (Blk. 17) (Sur. 10W) Map No.

Operator ElDorado Ref.

Well No. 1 Farm Stratman "B"

Elev. 1792 Location SE NE NE

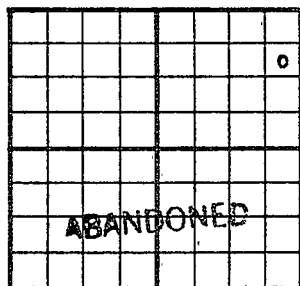

990 Ft. From N Line NE

330 Ft. From E Line Quarter

Ist. Report

Completion APR 9 1952

Remarks

Spudding Date 3-15-52

Drlg. Data D & A TD 3298

8" @ 278 Anhy 530 Heeb. 2792

Br. lime 2895 Lans. 2905 Cong. 3232

ReArb. 3239 Arb. 3243 TD 3246

5" @ 3244 DD 3256 B/ 2 goph 2 hr.

DD 3298 B/ 2 bailers fluid 1/2 hr.

PB 3257 500 A B/ 1 1/2 goph TD 3298

D & A

J. G. McGEHEE