

Ellsworth

Map No. KANSAS Sec. 23 Twp. 17 R. 9W

Well No. 6-Melchert Farm
Phillips Pet Company


_____ Ft. from N. Line

330 Ft. from S. Line

990 Ft. from E. Line

_____ Ft. from W. Line

Elev. 1790

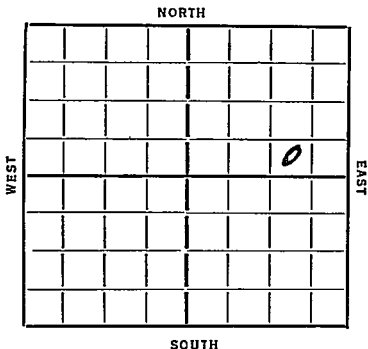

REPORT

~~1/22~~
 1/22 B.R.
 1/31 R.W.
 2/7 12" 132 TD 497 Reaming hole
 2/14 12" 455
 2/21 " 2010
 2/28 " 2925
 3/6 7" 3201 & top art
 TD 3202 woc
 3/18 7" 3201
 TD 3210
 1000 acid
 1317 Pbl.

COMPLETED

Map No. 48 Sec. 23 Twp. 17 R. 9W

Well No. 6 - Melchert

Phillips Pet Company

Contractor

SECTION PLAT

.....Ft. from N. Line

330 Ft. from S. Line

990 Ft. from E. Line

.....Ft. from W. Line

			o

FIRST REPORT

Location.....

Rig up.....

Drilling and Remarks:

B.R.

RECORD

Cased..... in.,ft.

Sand.....

Gas.....

Oil.....

Total Depth.....

PRODUCTION

1st 24 hrs. Nat.....

1st 24 hrs. after shot.....

Gas..... Cu. Ft.

Dry Hole.....

Abandoned.....

Date
JAN 22 1936

.....192.....

Scout

C. A. MANN-SCHRECK

Map No. 45 Sec. 23 Twp. 17 R. 9W

Well No. 6-Melchert

Phillips Company

Contractor

COMPLETED

SECTION PLAT

.....Ft. from N. Line

330 Ft. from S. Line

990 Ft. from E. Line

.....Ft. from W. Line

			0

Location.....

Rig up.....

Drilling and Remarks:

1000 acid

1317 hbls

RECORD

Cased.....in.,ft.

Sand Sil 3201

Gas.....

Oil.....

Total Depth 3210

PRODUCTION

1st 24 hrs. Nat.....

1st.24 hrs. after shot.....

Gas.....Cu. Ft.

Dry Hole.....

Abandoned.....

Date

MAR 18 1936 192.....

ORVAL MANNSCHRECK

Scout