


Ellsworth
17 R. 9 W

Map No. **KANSAS** Sec. *23* Twp. *17* R. *9 W*

Well No. *7- Melchert* Farm _____
Davis itab Company _____

NORTH

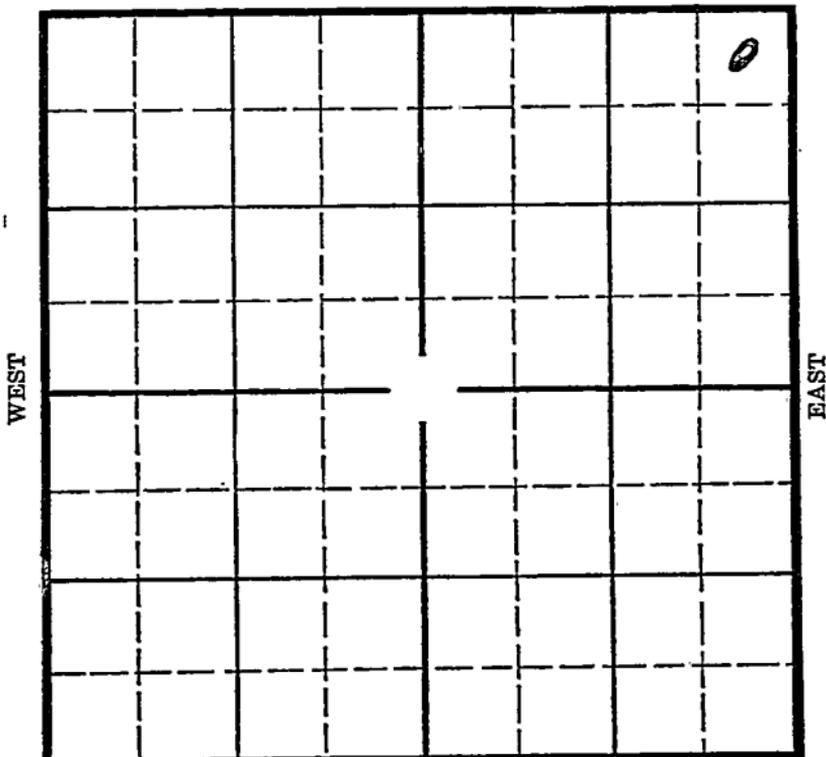

SOUTH

Location _____

Drilling Remarks _____

Rig Up _____

Drilling Remarks _____

RECORD

Cased _____ in. _____ ft.

Sand _____

Gas _____

Oil _____

Total Depth _____

PRODUCTION

1st 24 hrs. Nat. _____

1st 24 hrs. after shot _____

Gas _____ cu. ft. _____

Dry Hole _____

Abandoned _____

Ellsworth

Map No. KANCAS Sec. 23 Twp. 17 R. 9W


Well No. 7- Melchert Farm
Davis et al Company

330 Ft. from N. Line

_____ Ft. from S. Line

330 Ft. from E. Line

_____ Ft. from W. Line

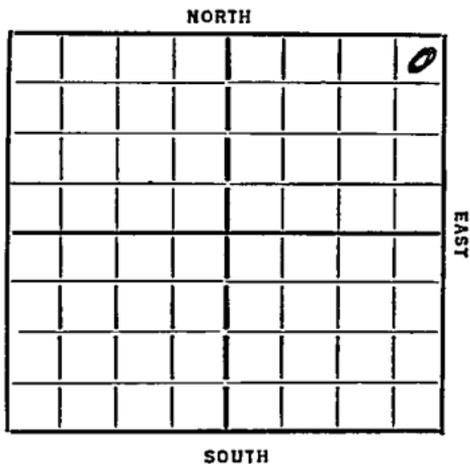

Elev. 1785

REPORT

Date	Notes
1935	
10/30	Cellar
11/7	_____
11/14	Ru Rotary
11/21	_____
11/29	dy 2200
12/6	Top Arbuckle 3183
	Runy 7"
12/13	7" 3192 Top Sil 3192
12/18	Sil 3190
	Oil 3190-93
	T 2 3194
	215 Bbls 21 hrs
	10% wtc.

COMPLETED

Map No. 45 Sec. 23 Twp. 17 R. 9W

Well No. 7-Melchert

Harris etal Company

Contractor

FIRST REPORTS

SECTION PLAT

330 Ft. from N. Line

..... Ft. from S. Line

330 Ft. from E. Line

..... Ft. from W. Line

			0

Location.....

Rig up.....

Drilling and Remarks:

cellar

RECORD

Cased..... in., ft.

Sand.....

Gas.....

Oil.....

Total Depth.....

PRODUCTION

1st 24 hrs. Nat.....

1st 24 hrs. after shot.....

Gas..... Cu. Ft.

Dry Hole.....

Abandoned.....

Date

10-30-35 192.....

ORVAL MANNSCHRECK
Scout

Edwards KANSAS
 Map No. *45* Sec. *23* Twp. *17* R. *9W*
 Well No. *7-Melchert*
Davis et al Company
 Contractor

COMPLETE

SECTION PLAT

330 Ft. from N. Line
 _____ Ft. from S. Line
330 Ft. from E. Line
 _____ Ft. from W. Line

			<i>0</i>

Location _____
 Rig up _____
 Drilling and Remarks:

215 bbls
21 hrs.
10 op W

RECORD

Cased _____ in. _____ ft.
 Sand *oil* *3190*
 Gas _____
 Oil *3190-93*
 Total Depth *3194*

PRODUCTION

1st 24 hrs. Nat. _____
 1st 24 hrs. after shot _____
 Gas _____ Cu. Ft.
 Dry Hole _____
 Abandoned _____

Date *12-18-35* 192

WELL MANUSCRIPT
 Scout