


Ellsworth

FORM 51 IOM 12-46 PETROL ~~TEXAS~~

Section 23 Township 17 Range 9W

Well No. 1 Malchert

Company R. H. Eymann

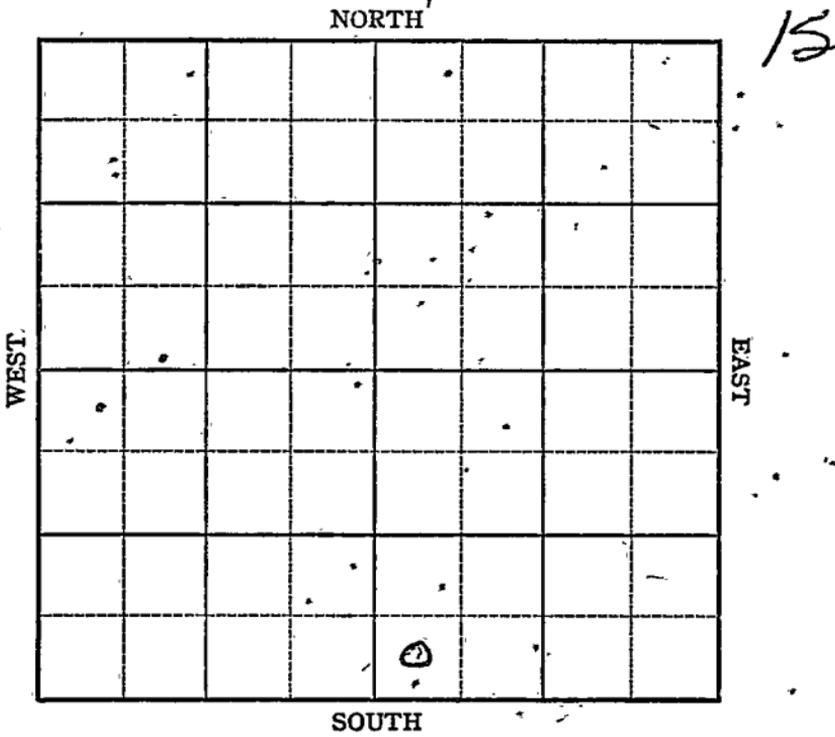

KANSAS

Ellsworth county

Sec. 23 Twp. 17 R. 9W

Well No. 1 Malchert<sup>1st</sup> Farm

R. H. Eyman Company


Lorraine pool.

Ft. from N. Line

330 Ft. from S. Line

Ft. from E. Line

330 Ft. from W. Line

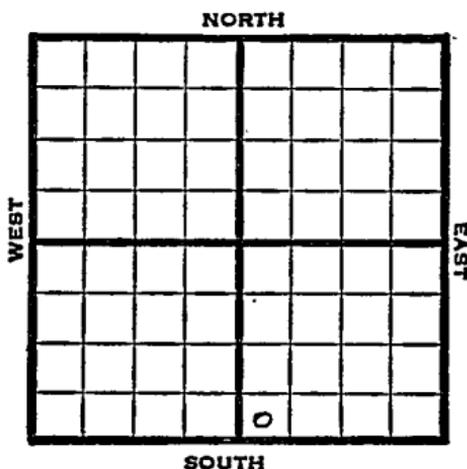

SW SE

1947

REPORT

5/28	Location
6/3	"
6/10	"
6/17	"
6/24	"
7/2	Location Abandoned.

**ABANDONED**

Map No. \_\_\_\_\_ Sec. 23 Twp. 17 R. 9W

Well No. 1 Malchert

R. H. Eyman Company

**FIRST REPORT**

Contractor

SW SE

**SECTION PLAT**


\_\_\_\_\_ Ft. from N. Line

330 Ft. from S. Line

\_\_\_\_\_ Ft. from E. Line

330 Ft. from W. Line

Ellsworth County

Location X

Rig up \_\_\_\_\_

Drilling and Remarks:

**RECORD**

Cased \_\_\_\_\_ in., \_\_\_\_\_ ft.

Sand \_\_\_\_\_

Gas \_\_\_\_\_

Oil \_\_\_\_\_

Total Depth \_\_\_\_\_

**PRODUCTION**

1st 24 hrs. Nat. \_\_\_\_\_

1st 24 hrs. after shot \_\_\_\_\_

Gas \_\_\_\_\_ Cu. Ft.

Dry Hole \_\_\_\_\_

Abandoned \_\_\_\_\_

Date

MAY 28 1947 19

S. J. LEWIS Scout

Map No. 45 Sec. 23 Twp. 17 R. 9W

Well No. 1 Malchert

R. H. Eyman Company

**ABANDONED** Contractor

SW SE

SECTION PLAT

\_\_\_\_\_ Ft. from N. Line

330 Ft. from S. Line

\_\_\_\_\_ Ft. from E. Line

330 Ft. from W. Line


Ellsworth County

Location ✓

Rig up \_\_\_\_\_

Drilling and Remarks:

RECORD

Cased \_\_\_\_\_ in., \_\_\_\_\_ ft.

Sand \_\_\_\_\_

Gas \_\_\_\_\_

Oil \_\_\_\_\_

Total Depth \_\_\_\_\_

PRODUCTION

1st 24 hrs. Nat. \_\_\_\_\_

1st 24 hrs. after shot \_\_\_\_\_

Gas \_\_\_\_\_ Cu. Ft.

Dry Hole \_\_\_\_\_

Abandoned \_\_\_\_\_

Date

JUL 2 1947 19

S. J. LEWIS Scout