


Section **23** Township **17** Range **9W**

Well No. **#1 Rolfs**

Company **Barge & Evans**

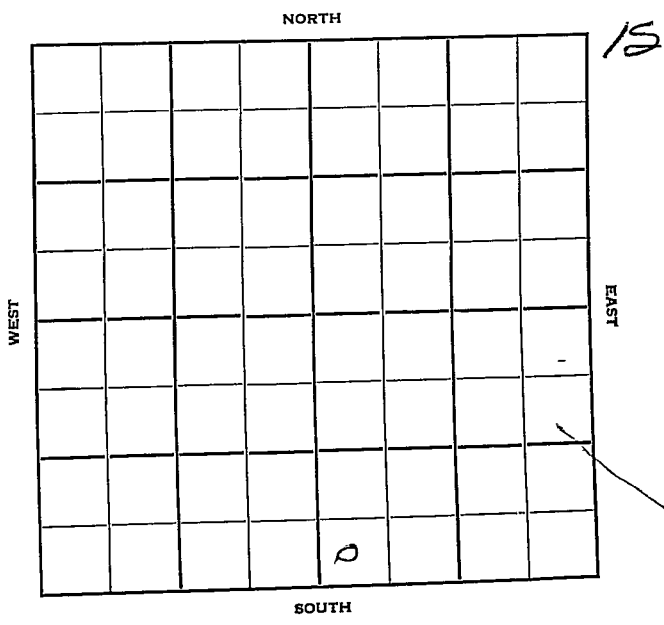

Ellsworth

KANSAS

Sec. 23 Twp. 17 R. 9W

Well No. #1 Rolfs Farm

Bargs & Evans Company

Rein Contractor


Ft. from N. Line

330 Ft. from S. Line

Ft. from E. Line

330 Ft. from W. Line

SW SW SE

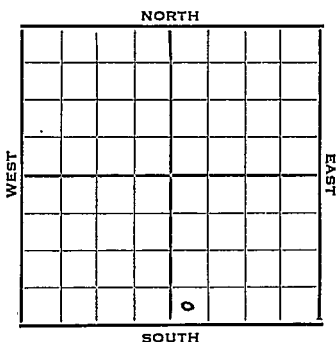

1952 Elev. 1777' REPORT

5/28 Cellar & Pits

6/11 Anhy 617'

Drlg. 2668'

6/18 Spud 6-3-52

D&A TD 3195

8" @ 221 Anhy 617

Heeb. 2716 Br lime 2836

Lans. 2853

DST 3014-51 opn 1 hr. Rec. 400' gas

190' ocm Simp 3172 Simp sd 3184

DST 3185-88 opn 1/2 hr. Rec. 6' mud

Arb. 3189


DST 3190-95 opn 40 min.

Rec. 2400' sw D&A

ABANDONED



J. G. McGEHEE

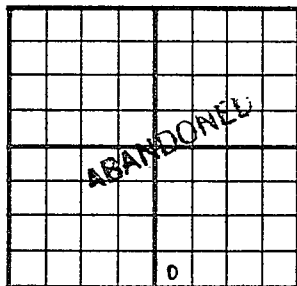County Ellsworth State KansasSec. 23 (Blk. Twp.) 17 (Sur. Rge.) 9W Map No.Operator Bargs & EvansWell No. 1 Farm RolfsElev. 1777 Location SW SW SE330 Ft. From S Line SE330 Ft. From W Line Quarter

1st. Report

Completion JUN 18 1952Remarks Rein PoolSpudding Date 6-3-52Drlg. Data D & A TD 31958" @ 221 Anhy 617 Heeb. 2716Br. lime 2836 Lans. 2853 DST 3014-51open 1 hr. Rec. 400' gas 190' ocmSimp. 3172 Simp. sd. 3184 DST 3185-88open $\frac{1}{2}$ hr. Rec. 6' mud Arb. 3189DST 3190-95 open 40 min. Rec. 2400' swD & A

J. G. McGEHEE