

KANSAS Ellsworth


Section 23 Township 17 Range 9WWell No. 1 RolfsCompany J.C. Dozier

Lorraine Pool

NORTH

WEST

EAST

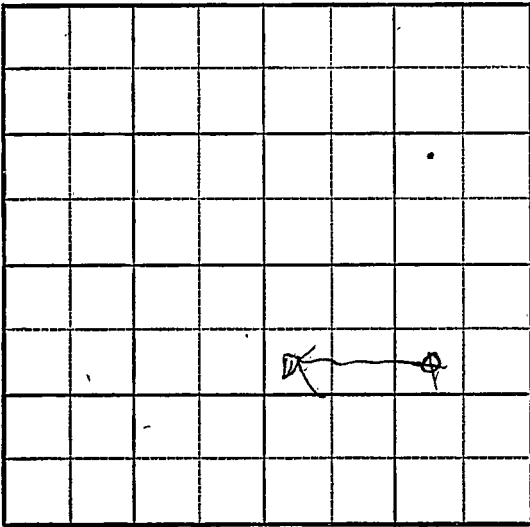

SOUTH

Sec. 23 Twp. 17 R. 9-W ✓

Well No. #1 Rolfs. Farm

J C Dozier Company

Lorraine


990 Ft. from N. Line

 Ft. from S. Line

990 Ft. from E. Line

330 Ft. from W. Line


~~SW NE SE~~ SW NW SE

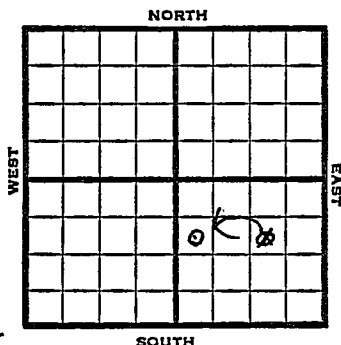

1948	Eli 1783' REPORT
10/6	8" @ 220'
10/13	Drlg 2820'
10/19	Simpson 3188'
	Arb. 3202'-05'
	TD 3205'
	5" @ 3203'
10/26	"
11/3	500 acid
	SO&W
11/10	"
11/16	" I
11 23	"
12/1	TD 3205'
	Arb. 3202'
	Aband.
	ABANDONED

Map No. _____ Sec. 23 Twp. 17 R. 9WWell No. 1 Rolfs_____J. C. Dozier_____Company_____FIRST REPORT_____Contractor
SW NE SE

SECTION PLAT

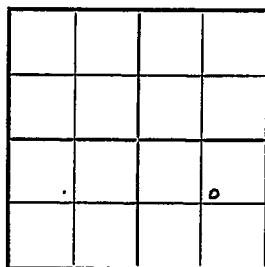990 Ft. from N. Line Ft. from S. Line990 Ft. from E. Line Ft. from W. LineEllsworth CountyLocation_____Rig up_____Drilling and Remarks:8" @ 220

RECORD

Cased_____ in., _____ ft.Sand_____Gas_____Oil_____Total Depth_____


PRODUCTION

1st 24 hrs. Nat._____1st 24 hrs. after shot_____Gas_____ Cu. Ft.Dry Hole_____Abandoned_____DateOCT 6 1948 19 S. J. LEWIS Scout

RECEIVED

TO THE

U. S. GEOLOGICAL SURVEY

 

U. S. GEOLOGICAL SURVEY

WASHINGTON, D. C.

U. S. GEOLOGICAL SURVEY

WASHINGTON, D. C.

U. S. GEOLOGICAL SURVEY

WASHINGTON, D. C.

Misc. Small Maps	_____
Cards	<i>[Signature]</i>
Tracing	_____
France Map	_____
Scarborough Map	_____
Pierce Map	_____
Cocological Dept.	_____
Pierce Plat Book	_____

Map No. 45 Sec. 23 Twp. 17 R. 9W

Well No. 1 Rolfs

J. C. Dozier Company

ABANDONED

Contractor

SW NW SE

EL 1783


SECTION PLAT

990 Ft. from N. Line

 Ft. from S. Line

 Ft. from E. Line

330 Ft. from W. Line

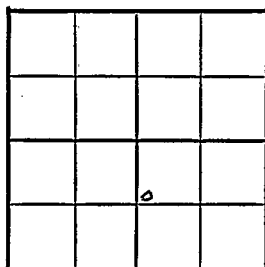

Ellsworth County

Location

Rig up

Drilling and Remarks:

Cr 8202

RECORD

Cased in., ft.

Sand

Gas

Oil

Total Depth 9285

PRODUCTION

1st 24 hrs. Nat.

1st 24 hrs. after shot

Gas Cu. Ft.

Dry Hole

Abandoned

Date

DEC 1 1948

S. J. LEWIS

Scout