





KANSAS

Form No. 111, Ed. 9-22

*Edwards*


Map No. *48* Sec. *23* Twp. *17* R. *9W*

Well No. *1-Dees*  
*Empire Oil* Company

Contractor

SECTION PLAT

*330* Ft. from N. Line  
..... Ft. from S. Line  
..... Ft. from E. Line  
*990* Ft. from W. Line

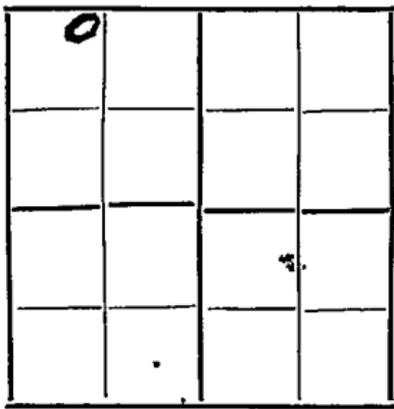

FIRST REPORT

Location.....

Rig up.....

Drilling and Remarks:

*B. R.*

RECORD

Cased.....in., .....ft.  
Sand.....  
Gas.....  
Oil.....  
Total Depth.....

PRODUCTION

1st 24 hrs. Nat.....  
1st 24 hrs. after shot.....  
Gas.....Cu. Ft.  
Dry Hole.....  
Abandoned.....

Date

*10-17-35* 192 *ORVAL MANNSCHRECK* Scout

Map No. 45 Sec. 23 Twp. 17 R. 9W

Well No. 1 - Dees

Empire Oil Company

Contractor

**COMPLETE**

**SECTION PLAT**

0			

330 Ft. from N. Line

..... Ft. from S. Line

..... Ft. from E. Line

990 Ft. from W. Line

Location.....

Rig up.....

Drilling and Remarks:

1938 P/O

**RECORD**

Cased..... in., ..... ft.

Sand Sil 3171

Gas.....

Oil.....

Total Depth 3173

**PRODUCTION**

1st 24 hrs. Nat.....

1st 24 hrs. after shot.....

Gas..... Cu. Ft.

Dry Hole.....

Abandoned.....

Date

11-27-35 192.....

OR 26 W. 17 N. 9 W. 23 S.

Scout