


Ellsworth
17 R. 9^W

Map No. KANSAS Sec. 23 Twp. 17 R. 9^W

Well No. 55 Deery Farm _____
Leys Co. Company _____

NORTH

3

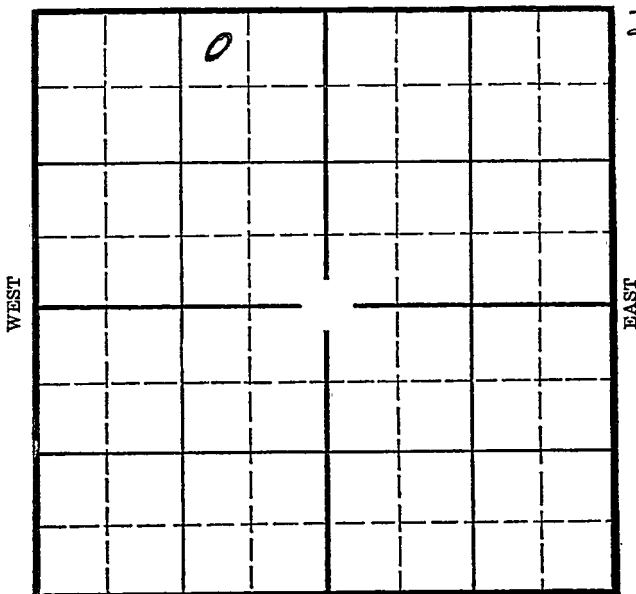

Location _____
Drilling Remarks _____

Rig Up _____
Drilling Remarks _____

RECORD

PRODUCTION

Cased _____ in. _____ ft.
Sand _____
Gas _____
Oil _____
Total Depth _____

1st 24 hrs. Nat. _____
1st 24 hrs. after shot _____
Gas _____ cu. ft. _____
Dry Hole _____
Abandoned _____

Ellsworth

KANSAS

Map No. _____ Sec. 23 Twp. 17 R. 9^W

Well No. 5- Deer Farm _____

Deer Company _____


330 Ft. from N. Line

_____ Ft. from S. Line

990 Ft. from E. Line

_____ Ft. from W. Line

NORTH

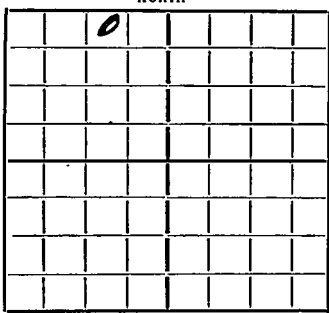

Elev. 1768

SOUTH

REPORT

Date 1935

9/17 Location 3162-65

10/3 Sil 3154-57. Sat Core.

10/10 Sil 3162-65 Corrected

10/17 Drilling

Sil 3162

TD 3165

1734 bbls

COMPLETED

Map No. 45 Sec. 23 Twp. 17 R. 9W

Well No. 5-Heis
Texas Co Company

Contractor

FIRST REPORTS

330 Ft. from N. Line
..... Ft. from S. Line
990 Ft. from E. Line
..... Ft. from W. Line

SECTION PLAT

	0		

Location
Rig up
Drilling and Remarks:

RECORD

Cased in., ft.
Sand
Gas
Oil
Total Depth

PRODUCTION

1st 24 hrs. Nat.
1st 24 hrs. after shot
Gas Cu. Ft.
Dry Hole
Abandoned

Date 9-12-35 192.....

ORVAL MANNSCHRECK

Scout

Form 26-1M Bks. 9-28
Ellsworth

Map No. 45 Sec. 23 Twp. 17 R. 9W

Well No. 5-Dees

Texas Company Company

Contractor

COMPLETE

SECTION PLAT

330 Ft. from N. Line

Ft. from S. Line

990 Ft. from E. Line

Ft. from W. Line

	0		

Location

Rig up

Drilling and Remarks:

1734 bbls

RECORD

Cased in. ft.

Sand 3162

Gas

Oil

Total Depth 3165

PRODUCTION

1st 24 hrs. Nat.

1st 24 hrs. after shot

Gas Cu. Ft.

Dry Hole

Abandoned

Date

10-17-35 192

ORVAL MANNSCHRECK

Scout