

Ellsworth

Map No.

KANSAS

Sec.

23

Twp.

17

R.

9W

Well No.

25 Lees
Lynn Co.

Farm


Company

NORTH

3

WEST

EAST

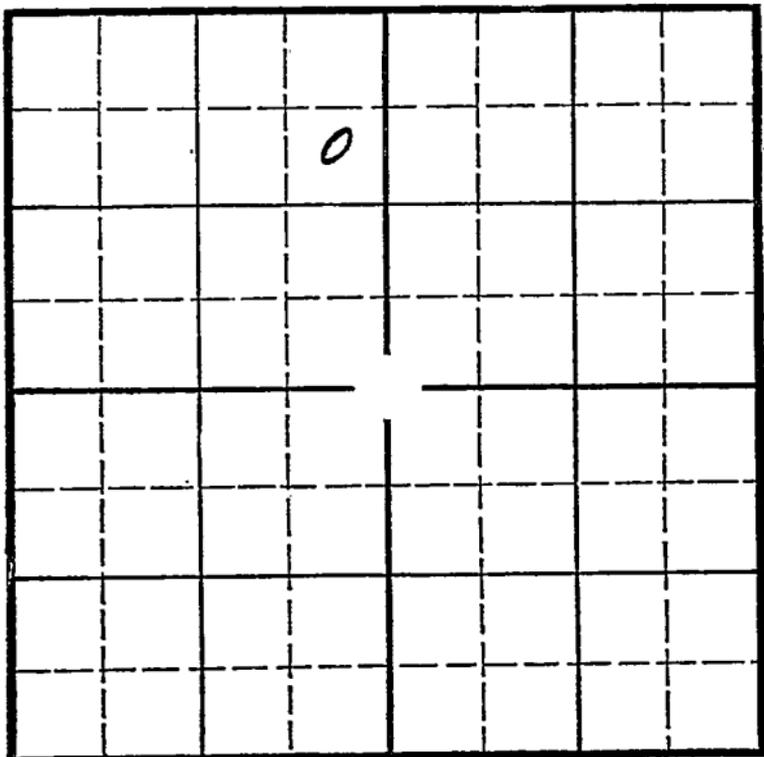

SOUTH

Location

Drilling Remarks

Rig Up

Drilling Remarks

RECORD

Cased _____ in. _____ ft.

Sand _____

Gas _____

Oil _____

Total Depth _____

PRODUCTION

1st 24 hrs. Nat. _____

1st 24 hrs. after shot _____

Gas _____ cu. ft. _____

Dry Hole _____

Abandoned _____

Ellsworth
17 9th

Map No. KANSAS Sec. 23 Twp. 17 R. 9th

Well No. 2-Deer Farm _____
Lyons Co. Company _____


990 Ft. from N. Line

_____ Ft. from S. Line

330 Ft. from E. Line

_____ Ft. from W. Line

Elev. 1775

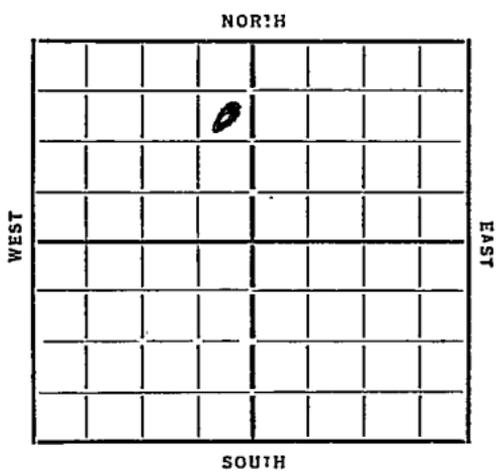

| Date | REPORT |
|------|----------------------------|
| 1935 | |
| 8/21 | Bldg Rig |
| 8/29 | 12500 |
| 9/6 | " 2614 |
| 10/3 | Sil 3172-75 |
| | 1134 Bbls 20 hrs 1000 acid |
| 10/9 | Sil 3172 |
| | TD 3175 |
| | 1000 acid |
| | 1823 Bbls. |
| | |
| | |
| | |
| | |
| | |
| | |
| | |
| | |
| | |
| | |

COMPLETED

Ellsworth

KANSAS

Form 29 - 1st 45ks. 29-28

Map No. 45 Sec. 23 Twp. 17 R. 9W

Well No. 2-Dieo

Texas Co Company

Contractor

FIRST REPORTS

SECTION PLAT

990 Ft. from N. Line

Ft. from S. Line

330 Ft. from E. Line

Ft. from W. Line

| | | | |
|--|---|--|--|
| | | | |
| | 0 | | |
| | | | |
| | | | |
| | | | |

Location

Rig up

Drilling and Remarks:

Bldg Rig

RECORD

Cased in., ft.

Sand

Gas

Oil

Total Depth

PRODUCTION

1st 24 hrs. Nat.

1st 24 hrs. after shot

Gas Cu. Ft.

Dry Hole

Abandoned

Date

8-21-35 192

CRYAL MANNSCHRECK

Scout

Form 26-101 Rev. 9-26
Ellsworth

KANSAS

Map No. *45* Sec. *23* Twp. *17* R. *9W*

Well No. *2-Dee*

Texas Co Company

Contractor

COMPLETED

SECTION PLAT

| | | | |
|--|---|--|--|
| | | | |
| | 0 | | |
| | | | |
| | | | |
| | | | |

990 Ft. from N. Line

..... Ft. from S. Line

330 Ft. from E. Line

..... Ft. from W. Line

Location.....

Rig up.....

Drilling and Remarks:

1000 and

1823 lbs

RECORD

Cased..... in. ft.

Sand..... *3172*

Gas.....

Oil.....

Total Depth. *3172*

PRODUCTION

1st 24 hrs. Nat.....

1st 24 hrs. after shot.....

Gas..... Cu. Ft.

Dry Hole.....

Abandoned.....

Date

ORVAL MANNSCHRECK

10-9-35 192.....

Scout