


Ellsworth 17 9W



NORTH

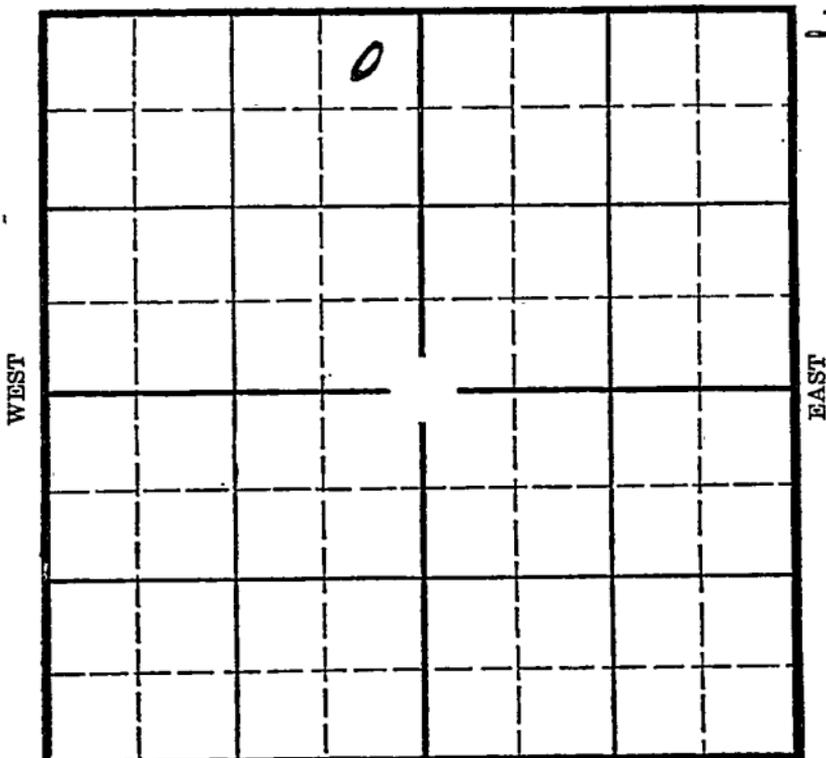

SOUTH

Location _____
Drilling Remarks _____

Rig Up _____
Drilling Remarks _____

RECORD

PRODUCTION

Cased _____ in. _____ ft.
Sand _____
Gas _____
Oil _____
Total Depth _____

1st 24 hrs. Nat. _____
1st 24 hrs. after shot _____
Gas _____ cu. ft. _____
Dry Hole _____
Abandoned _____

Ellsworth

Map No. KANSAS Sec. 23 Twp. 17 R. 9W

Well No. 1- Dees Farm
Texas Co. Company


330 Ft. from N. Line

_____ Ft. from S. Line

330 Ft. from E. Line

_____ Ft. from W. Line

Elevation 1776

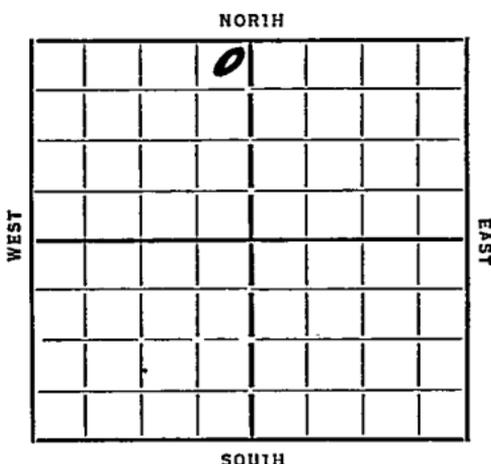

Date 1935 REPORT

7/10 Location

7/18 A.R.

8/8 Dlg 3040 N @ 2865

8/15 Sil 3169 3175 T7

Run 7"

8/22 7" 3169 HFO 1 1/2 hrs.

8/28 Sil 3169

T7 3175

1907 Balw.

COMPLETED.

Edsworth
Map No. 45 Sec. 23 Twp. 17 R. 9W

Well No. 1-Dees
Texas Co Company

Contractor

FIRST REPORTS

SECTION PLAT

330 Ft. from N. Line
..... Ft. from S. Line
330 Ft. from E. Line
..... Ft. from W. Line

	0		

Location.....

Rig up.....

Drilling and Remarks:

for

RECORD

Cased..... in., ft.
Sand.....
Gas.....
Oil.....
Total Depth.....

PRODUCTION

1st 24 hrs. Nat.....
1st 24 hrs. after shot.....
Gas..... Cu. Ft.
Dry Hole.....
Abandoned.....

Date

7-10-35 192.....

ORIGINAL MANUSCRIPT

Scout

Map No. 45 Sec. 23 Twp. 17 R. 9W

Well No. 1-Dees

Texas Company Company
Contractor

~~COMPLETED~~

SECTION PLAT

330 Ft. from N. Line
..... Ft. from S. Line
330 Ft. from E. Line
..... Ft. from W. Line

	<u>60</u>		

Location.....
Rig up.....
Drilling and Remarks:

RECORD

Cased..... in., ft.
Sand Sil 3169
Gas.....
Oil.....
Total Depth 3175

PRODUCTION

1st 24 hrs. Nat.....
1st 24 hrs. after shot.....
Gas..... Cu. Ft.
Dry Hole.....
Abandoned.....

1907 Hh

Date 8-28-35 192.....

~~ORVAL MANNSCHRECK~~

Scout