

Map No.

KANSAS

Sec.

23

Twp.

17

R.

9^W

Well No.

62 Lees
Lynn Co.

Farm

Company

NORTH

WEST

EAST

SOUTH

Location

Drilling Remarks

Rig Up

Drilling Remarks

RECORD

Cased _____ in. _____ ft.

Sand _____

Gas _____

Oil _____

Total Depth _____

PRODUCTION

1st 24 hrs. Nat. _____

1st 24 hrs. after shot _____

Gas _____ cu. ft. _____

Dry Hole _____

Abandoned _____

Ellsworth

Map No. 23 Sec. 17 Twp. 9th

Well No. 6-Deer Farm

Super Co. Company


990 Ft. from N. Line

_____ Ft. from S. Line

990 Ft. from E. Line

_____ Ft. from W. Line

Elev. 1774

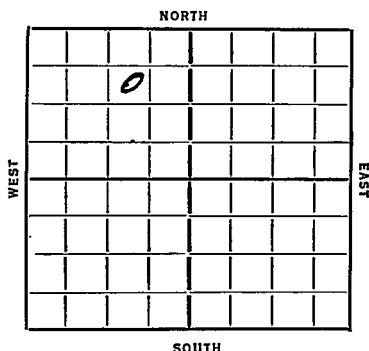

Date	REPORT
1935	
10/2	Location
10/10	Qty 208
11/1	Top Sil 3170 TD 3171 1/2 Feet
11/7	TD 3176 1000' Oil 12 hrs.
11/4	1000 acid pump 100 Oil 2 hrs
	Re acid rig
11/21	pumper 105 Hols 15 hrs
	Qty deeper
11/29	Drilled to TD 3180
	No Incy Co.
12/6	3181 Swabbed 37 Oil 7 hrs
	Shot 20 Gts 3178-81
	TD 3186 Swabbed 60 Oil 10 hrs C.O.
12/11	T. Sil 3170
	TD 3186
	2000 acid
	Prod 848 Oil
	1 1/2 % water
	COMPLETED


Map No. 45 Sec. 23 Twp. 17 R. 9W

Well No. 6-Dees

Texas Co. Company

Contractor

FIRST REPORTS

990 Ft. from N. Line

Ft. from S. Line

990 Ft. from E. Line

Ft. from W. Line

SECTION PLAT

	0		

Location ✓

Rig up

Drilling and Remarks:

RECORD

Cased in., ft.

Sand

Gas

Oil

Total Depth

PRODUCTION

1st 24 hrs. Nat.

1st 24 hrs. after shot

Gas Cu. Ft.

Dry Hole

Abandoned

Date

ORVAL MANNSCHRECK

10-2-35 192

Scout

Map No. 45 Sec. 23 Twp. 17 R. 9W

Well No. 6-Dees

Texas Company

Contractor

SECTION PLAT

990 Ft. from N. Line

_____ Ft. from S. Line

990 Ft. from E. Line

_____ Ft. from W. Line

	0		

COMPLETED

Location _____

Rig up _____

Drilling and Remarks:

2000 acid

Pat 848 oil

1 1/2 % water

RECORD

Cased _____ in., _____ ft.

Sand T. Sil 3170

Gas _____

Oil _____

Total Depth 3186

PRODUCTION

1st 24 hrs. Nat. _____

1st 24 hrs. after shot _____

Gas _____ Cu. Ft.

Dry Hole _____

Abandoned _____

Date

12-11-35 192. _____ Scout

ORVAL MANNSCHRECK