

Ellsworth

Map No. KANSAS Sec. 23 Twp. 17 R. 9W


Well No. 1-Grath Farm _____
Carter et al Company _____

330 Ft. from N. Line

_____ Ft. from S. Line

330 Ft. from E. Line

_____ Ft. from W. Line

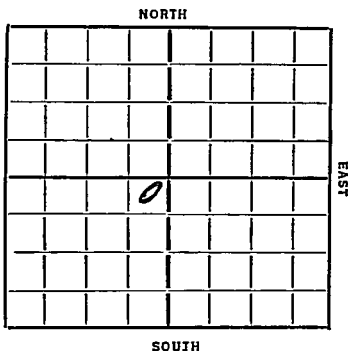

Elevation 1775

REPORT

Date	Description
1935	
10/2	Location
10/10	Rot Rig
11/1	Log 2446
11/7	No 3165 Rust
11/14	Log 3193-96 1800' Oil 10 hrs
	Acidizing
11/20	Log 3193
	TD 3196
	1128 1700' Oil
	150 Water

COMPLETED

Edworth
Map No. *45* Sec. *23* Twp. *17* R. *9W*

Well No. *1-Brath*
Carter etal Company

Contractor

CO.

SECTION PLAT

330 Ft. from N. Line

Ft. from S. Line

330 Ft. from E. Line

Ft. from W. Line

	<i>0</i>		

Location

Rig up

Drilling and Remarks:

1128 bbl oil
150 water

RECORD

Cased _____ in. _____ ft.

Sand *sil 3193*

Gas _____

Oil _____

Total Depth *3196*

PRODUCTION

1st 24 hrs. Nat. _____

1st 24 hrs. after shot _____

Gas _____ Cu. Ft.

Dry Hole _____

Abandoned _____

Date

11-20-35 192

W. W. HARRIS Scout