

Map No. **KANSAS** Sec. **23** Twp. **17** R. **9W**  
 Well No. **5-Melcher** Farm  
**Phillips Pet** Company

NORTH

7

WEST

EAST

SOUTH

Location

Drilling Remarks

Rig Up

Drilling Remarks

## RECORD

Cased \_\_\_\_\_ in. \_\_\_\_\_ ft.

Sand \_\_\_\_\_

Gas \_\_\_\_\_

Oil \_\_\_\_\_

Total Depth \_\_\_\_\_

## PRODUCTION

1st 24 hrs. Nat. \_\_\_\_\_

1st 24 hrs. after shot \_\_\_\_\_

Gas \_\_\_\_\_ cu. ft.

Dry Hole \_\_\_\_\_

Abandoned \_\_\_\_\_


Ellsworth

Map No. 23 Sec. 17 Twp. 9W

Well No. 5 Melcher Farm

Phillips 1st Company

NORTH

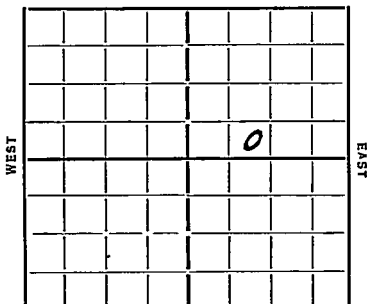

WEST

EAST

SOUTH

Ft. from N. Line

229 Ft. from S. Line

Ft. from E. Line

990 Ft. from W. Line

Elev. 1787

Date 1/23/35 REPORT

11/20 Moving In  
11/29 Digging surface hole  
12/6 Dig 1635  
12/13 " 3065  
12/19 Top Sil 3196 7" 3196  
May 3204-5" TD 3206  
100' OTH, 2 hrs R. tubg  
12/26 pumped 654 Oil 24 hrs  
May treat  
1/2/36  
1/8 Sil 3196  
TD 3206  
1000 acid  
Pot 1417 Oil

COMPLETED

Map No. 45 Sec. 23 Twp. 17 R. 9WWell No. 5-MelcherPhillips Company

Contractor

## FIRST REPORTS

Ft. from N. Line

229 Ft. from S. Line

Ft. from E. Line

990 Ft. from W. Line

## SECTION PLAT

|  |  |   |  |
|--|--|---|--|
|  |  |   |  |
|  |  |   |  |
|  |  | o |  |
|  |  |   |  |
|  |  |   |  |

Location.....

Rig up.....

Drilling and Remarks:

Moving in

## RECORD

Cased.....in., .....ft.

Sand.....

Gas.....

Oil.....

Total Depth.....

## PRODUCTION

1st 24 hrs. Nat.....

1st 24 hrs. after shot.....

Gas.....Cu. Ft.

Dry Hole.....

Abandoned.....

Date

ORVAL MANNSCHRECK

11-20-35 192.....

Scout

Map No. 45 Sec. 23 Twp. 17 R. 9W

Well No. 5-Melcher

Phillips Company

Contractor

SECTION PLAT

Ft. from N. Line

229 Ft. from S. Line

Ft. from E. Line

990 Ft. from W. Line

COMPLETED

|  |  |  |  |
|--|--|--|--|
|  |  |  |  |
|  |  |  |  |
|  |  |  |  |
|  |  |  |  |
|  |  |  |  |

Location

Rig up

Drilling and Remarks:

1000 acid

Pat. 1417 oil

RECORD

Cased \_\_\_\_\_ in., \_\_\_\_\_ ft.

Sand Sil. 3196

Gas \_\_\_\_\_

Oil \_\_\_\_\_

Total Depth 3206

PRODUCTION

1st 24 hrs. Nat. \_\_\_\_\_

1st 24 hrs. after shot \_\_\_\_\_

Gas \_\_\_\_\_ Cu. Ft.

Dry Hole \_\_\_\_\_

Abandoned \_\_\_\_\_

Date

JAN 8 1936 192 ORVAL MANNSCHRECK Scout