



Ellsworth

KANSAS

Map No. \_\_\_\_\_ Sec. 23 Twp. 17 R. 9 W

Well No. 4- Melcher Farm \_\_\_\_\_

Phillips


Company \_\_\_\_\_

\_\_\_\_\_ Ft. from N. Line

990 Ft. from S. Line

990 Ft. from E. Line

\_\_\_\_\_ Ft. from W. Line

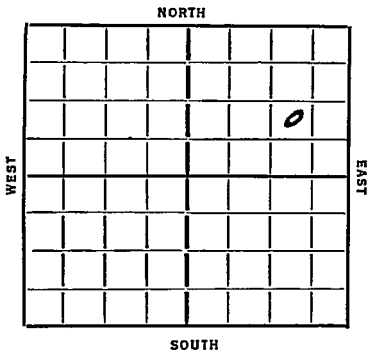

Elev. 1789

REPORT

Date

1935  
9/25 Location

10/3 \_\_\_\_\_

10/10 dly 460

11/1 7" 3196 Top bit & T.D.

11/6 bit 3196

T.D 3200

800 lbs

COMPLETED

Map No. 45 Sec. 33 Twp. 17 R. 9W

Well No. 4-Melcher

Phillips Company

Contractor

FIRST REPORTS

SECTION PLAT

Ft. from N. Line

990 Ft. from S. Line

990 Ft. from E. Line

Ft. from W. Line

			0

Location

Rig up

Drilling and Remarks:

RECORD

Cased.....in., .....ft.

Sand.....

Gas.....

Oil.....

Total Depth.....

PRODUCTION

1st 24 hrs. Nat.....

1st 24 hrs. after shot.....

Gas.....Cu. Ft.

Dry Hole.....

Abandoned.....

Date

ERVAL MANNSCHRECK

9-25-35 192

Scout

*Edwards*  
Form 28 (1M) 1-1-36

KANSAS

Map No. *45* Sec. *23* Twp. *17* R. *9W*

Well No. *4-Melcher*

*Phillips pet.* Company

Contractor

COMPLETED

SECTION PLAT

			0

..... Ft. from N. Line

*990* Ft. from S. Line

*990* Ft. from E. Line

..... Ft. from W. Line

Location.....

Rig up.....

Drilling and Remarks:

*800 bbls*

RECORD

Cased..... in..... ft.

Sand *Sil 3196*

Gas.....

Oil.....

Total Depth *3200*

PRODUCTION

1st 24 hrs. Nat.....

1st 24 hrs. after shot.....

Gas..... Cu. Ft.

Dry Hole.....

Abandoned.....

Date

*11-6-35* 192.....

ORVAL MANNSCHRECK

Scout