

KANSAS


Form 51-5M-4-36-Palace

McPherson

Section 23 Township 17 Range 9W

Well Number #3 Groth

Company Carter

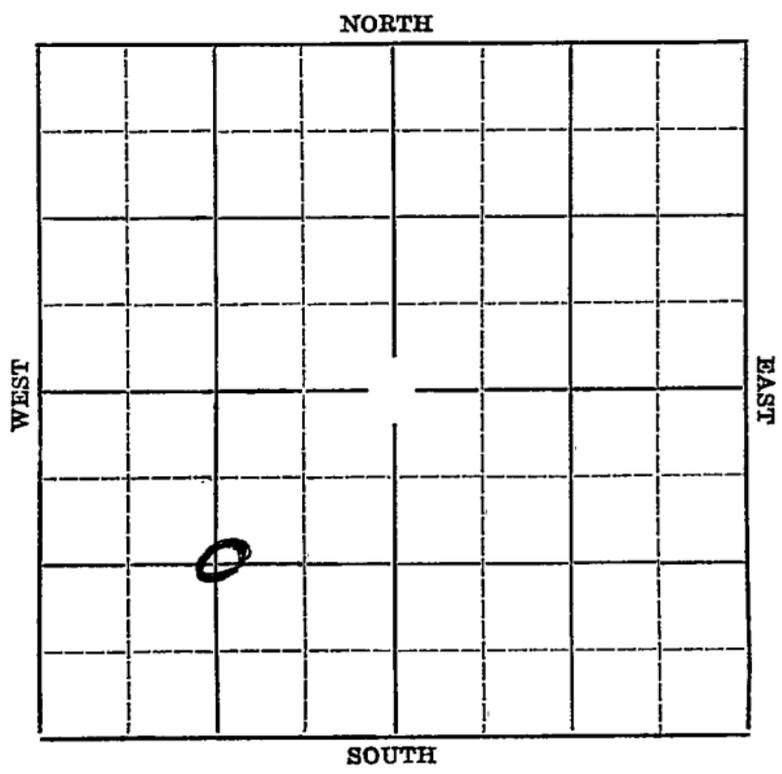

11

Map No. KANSAS Sec. 25 Twp. 17 R. 9W

Well No. #3 Groth Farm

Carter Company


_____ Ft. from N. Line

1320' Ft. from S. Line

_____ Ft. from E. Line

1320' Ft. from W. Line

Elev. 1775

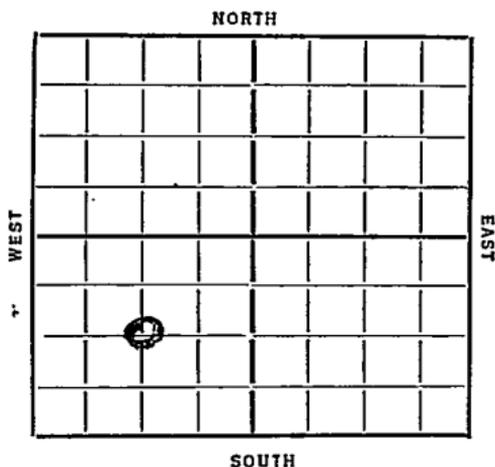

Date
1936

REPORT

6/3 Cellar.

6/11 10" @ 204'. 208' Wait on cement.

7/8/36-Sil. 3183'.

T.D. 3187'.

1365 bbls of oil in 22 hours Nat

COMPLETED

KANSAS

Form 26 IM Bks. 2-20
Carters

Map No. 45 Sec. 23 Twp. 17 R. 9W

Well No. 3 Guth.

Carters Company

Contractor

SECTION PLAT

○			

_____ Ft. from N. Line

1320 Ft. from S. Line

_____ Ft. from E. Line

1820 Ft. from W. Line

FIRST REPORT

Location _____

Rig up _____

Drilling and Remarks:

O & Har

RECORD

Cased _____ in., _____ ft.

Sand _____

Gas _____

Oil _____

Total Depth _____

PRODUCTION

1st 24 hrs. Nat. _____

1st 24 hrs. after shot _____

Gas _____ Cu. Ft.

Dry Hole _____

Abandoned _____

Date

JUN 3 1936

19


S. J. LEWIS Scout

Map No. 45 Sec. 23 Twp. 17 R. 9WWell No. 3 Grotto.Carters.

Company

Contractor

SECTION PLAT

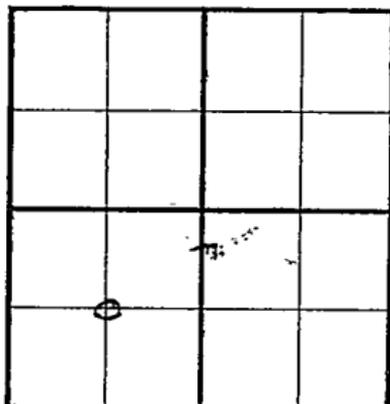

_____ Ft. from N. Line

1820 Ft. from S. Line

_____ Ft. from E. Line

1820 Ft. from W. Line**COMPLETED**

Location _____

Rig up _____

Drilling and Remarks:

Oil 31831365 1/2 x 22 hrs
Nat.

RECORD

Cased _____ in., _____ ft.

Sand _____

Gas _____

Oil _____

Total Depth 3187

PRODUCTION

1st 24 hrs. Nat. _____

1st 24 hrs. after shot _____

Gas _____ Cu. Ft.

Dry Hole _____

Abandoned _____

Date

JUL 8 1936 19

S. J. LEWIS

Scout