

Map No.

KANSAS

Sec.

23

Twp.

Allsworth, 17 R. 9^W

Well No.

3-

Melcher
Phillips Pet

Farm

Company

NORTH

WEST

EAST

SOUTH

Location

Drilling Remarks

Rig Up

Drilling Remarks

RECORD

Cased _____ in. _____ ft.

Sand _____

Gas _____

Oil _____

Total Depth _____

PRODUCTION

1st 24 hrs. Nat. _____

1st 24 hrs. after shot _____

Gas _____ cu. ft. _____

Dry Hole _____

Abandoned _____

Ellsworth

Map No. KANSAS Sec. 23 Twp. 17 R. 9W

Well No. 3- Melcher Farm
Phillips Pet Company


 Ft. from N. Line

990 Ft. from S. Line

 Ft. from E. Line

330 Ft. from W. Line

Elev. 1782

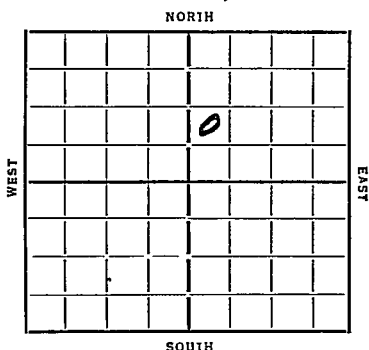

Date 1935 REPORT

8/14 Location
8/22 Rig
8/29 120 447 WOC
9/6 Log 2400
9/25 Ad 3191-94
T 17 3194
1109 Blk.

COMPLETED

Edswarth
Map No. 45 Sec. 23 Twp. 17 R. 9WWell No. 3-MelcherPhillips pet Company

Contractor

FIRST REPORT

Ft. from N. Line

990 Ft. from S. Line

Ft. from E. Line

330 Ft. from W. Line

SECTION PLAT

		o	

FIRST REPORT

Location ✓

Rig up

Drilling and Remarks:

RECORD

Cased in., ft.Sand Gas Oil Total Depth

PRODUCTION

1st 24 hrs. Nat. 1st 24 hrs. after shot Gas Cu. Ft.Dry Hole Abandoned

Date

8-14-35 192

ORVAL MANN SCHRECK

Scout

Edwards
 Map No. 45 Sec. 23 Twp. 17 R. 9W
 Well No. 3-Melcher
Phillips Pet Company
 Contractor

COMPLETED

SECTION PLAT

		0	

Ft. from N. Line

990 Ft. from S. Line

Ft. from E. Line

330 Ft. from W. Line

Location

Rig up

Drilling and Remarks:

1109 lbs

RECORD

Cased _____ in. _____ ft.

Sand Sil 3191-94

Gas _____

Oil _____

Total Depth 3194

PRODUCTION

1st 24 hrs. Nat. _____

1st 24 hrs. after shot _____

Gas _____ Cu. Ft.

Dry Hole _____

Abandoned _____

Date

J. VAL MANNSCHRECK

9-25-35 192

Scout