


Map No. 23 Sec. 17 Twp. 9W
 Well No. 63 Melcher Farm
C. B. Davis Company

NORTH

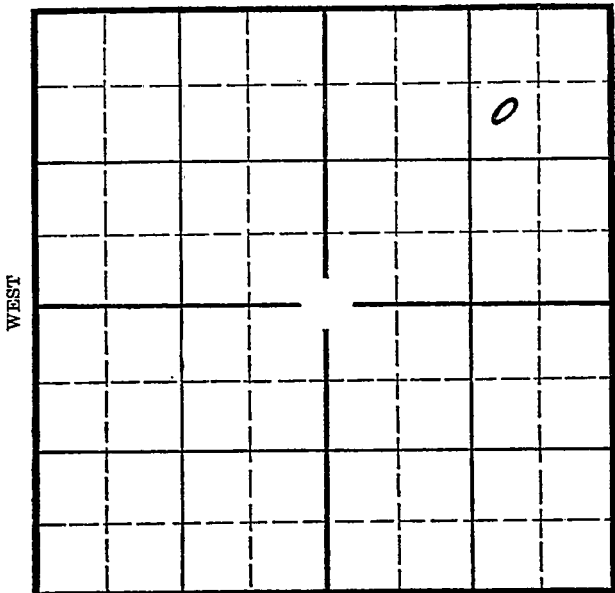

SOUTH

Location _____
 Drilling Remarks _____

Rig Up _____
 Drilling Remarks _____

RECORD

Cased _____ in. _____ ft.
 Sand _____
 Gas _____
 Oil _____
 Total Depth _____

PRODUCTION

1st 24 hrs. Nat. _____
 1st 24 hrs. after shot _____
 Gas _____ cu. ft. _____
 Dry Hole _____
 Abandoned _____

Sec. 23 Twp. 17 R. 9th

Well No. 6- Melcher Farm C. B. Davis Company

Company

990 Ft. from N. Line

Ft. from S. Line

990 Ft. from E. Line

Ft. from W. Line

NORTH

[illegible]

WEST

EAST

SOUTH

Elev. 1785

Date _____

REPORT

1935	
10/7	hot pig
10/10	
10/11	
10/10 April

10/10	Spunk
11/11	Don. Sals 3179 Rust

11/1	stop	46	21
11/3	11.7	31	79

TD 3193

1342	Bbls
------	------

COMPLETED

KANSAS

Map No. 45 Sec. 23 Twp. 17 R. 9ⁿWell No. 6-MelcherC. B. Davis Company

Contractor

FIRST REPORTS

SECTION PLAT

990 Ft. from N. Line

Ft. from S. Line

990 Ft. from E. Line

Ft. from W. Line

			0

Location

Rig up

Drilling and Remarks:

Pat Rig

RECORD

Cased _____ in., _____ ft.

Sand _____

Gas _____

Oil _____

Total Depth _____

PRODUCTION

1st 24 hrs. Nat. _____

1st 24 hrs. after shot _____

Gas _____ Cu. Ft.

Dry Hole _____

Abandoned _____

Date

ORVAL MANNSCHRECK

10-2-35 192 _____ Scout

Map No. 45 Sec. 23 Twp. 17 R. 9W

Well No. 6-Melcher

C. B. Davis Company

Contractor

SECTION PLAT

			0

990 Ft. from N. Line

Ft. from S. Line

990 Ft. from E. Line

Ft. from W. Line

Location

Rig up

Drilling and Remarks:

1342 bbs

RECORD

Cased _____ in _____ ft.

Sand oil 3179

Gas _____

Oil _____

Total Depth 3193

PRODUCTION

1st 24 hrs. Nat. _____

1st 24 hrs. after shot _____

Gas _____ Cu. Ft.

Dry Hole _____

Abandoned _____

Date

11-13-35 192 12th MANSFIELD REEF Scout