

Ellsworth

Map No. KANSAS Sec. 23 Twp. 17 R. 9^W

Well No. 2-Melcher Farm
C. B. Davis et al Company


330 Ft. from N. Line

_____ Ft. from S. Line

_____ Ft. from E. Line

990 Ft. from W. Line

NORTH

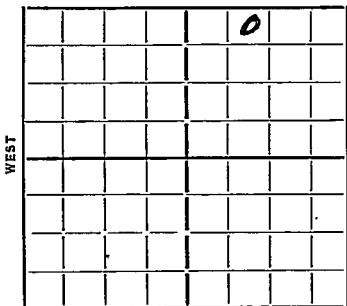

SOUTH

Elev. 1781

Date _____ REPORT

1935
5/15 Moving

5/29 Rotary Rig

6/6 Ream

6/20 517 1540

6/28 517 2710

7/3 698 3183 40 Rust

7/11 3183 14FO 3190-95
Tubing

7/18

7/24 3183 TD 3195
pump 1519 Oil

COMPLETED

Edworth

Map No. *45* Sec. *23* Twp. *17* R. *9W*

Well No. *2-Melcher*

C. B. Harris et al Company

Contractor

FIRST REPORTS


SECTION PLAT

330 Ft. from N. Line

..... Ft. from S. Line

..... Ft. from E. Line

990 Ft. from W. Line

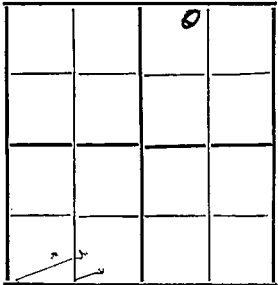

Location.....

Rig up.....

Drilling and Remarks:

Nothing

RECORD

Cased.....in.,ft.

Sand.....

Gas.....

Oil.....

Total Depth.....

PRODUCTION

1st 24 hrs. Nat.....

1st 24 hrs. after shot.....

Gas.....Cu. Ft.

Dry Hole.....

Abandoned.....

Date

5-15-35 192.....

ORVAL MANNSCHRECK

Scout

Map No. 45 Sec. 23 Twp. 17 R. 9W

Well No. 2 Welcher

C. B. Davis Company

Contractor



SECTION PLAT

330 Ft. from N. Line

..... Ft. from S. Line

..... Ft. from E. Line

990 Ft. from W. Line

		0	

Location.....

Rig up.....

Drilling and Remarks:

Sil 3183

Pump 1519 oil

RECORD

Cased.....in.,ft.

Sand.....

Gas.....

Oil.....

Total Depth 3195

PRODUCTION

1st 24 hrs. Nat.....

1st 24 hrs. after shot.....

Gas.....Cu. Ft.

Dry Hole.....

Abandoned.....

Date

ORVAL MANNSCHRECK

7/24/35 192.....

Scout