

Map No.

KANSAS

Sec.

23

Twp.

17

R.

9^W

Well No.

1- Melcher

Farm

Davis & Winkler - Koch

Company

NORTH

WEST

EAST

SOUTH

Location

Drilling Remarks

Rig Up

Drilling Remarks

RECORD

Cased _____ in. _____ ft.

Sand _____

Gas _____

Oil _____

Total Depth _____

PRODUCTION

1st 24 hrs. Nat. _____

1st 24 hrs. after shot _____

Gas _____ cu. ft. _____

Dry Hole _____

Abandoned _____

Well No. 1- Melcher Farm


Davis & Winkler-Koch Company

330 Ft. from N. Line

Ft. from S. Line

990 Ft. from E. Line

Ft. from W. Line

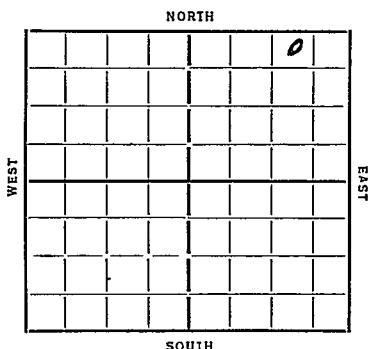

Date _____

REPORT

1932 3/20	Location
--------------	----------

15/28

4/4	Pounds
-----	--------

4/11	Roy
------	-----

4/8	Rt Rio
-----	--------

4/26	—
------	---

5/2 10" 212

5/9 *Ala* 2490

5/16 Nil 3189 7" 3190

T 7 3193 W0C

5/2,3 T 7 3194

15/29 take. potential

6/5 Liliseau 3189 T 11 3194

1804 Bhs 22 1/2 hrs

COMPLETED

Edenworth

Map No. 45 Sec. 23 Twp. 17 R. 9W

Well No. 1- Melcher

Davist Winkler-Rocha Company

FIRST REPORTS

Contractor

SECTION PLAT

			0
			0

330 Ft. from N. Line

Ft. from S. Line

990 Ft. from E. Line

Ft. from W. Line

Location ✓

Rig up

Drilling and Remarks:

RECORD

Cased in., ft.

Sand

Gas

Oil

Total Depth

PRODUCTION

1st 24 hrs. Nat.

1st 24 hrs. after shot

Gas Cu. Ft.

Dry Hole

Abandoned

Date

ORVAL

3-20-35 192 Scout

Map No. 45 Sec. 23 Twp. 17 R. 9WWell No. 1-MelcherMorris-Winkler-Koch Company

Contractor

SECTION PLAT

			0

330 Ft. from N. Line

Ft. from S. Line

990 Ft. from E. Line

Ft. from W. Line

Location

Rig up

Drilling and Remarks:

1804 bbls
22½ hrs

RECORD

Cased _____ in., _____ ft.

Sand siliceous 3189

Gas _____

Oil _____

Total Depth 3194

PRODUCTION

1st 24 hrs. Nat. _____

1st 24 hrs. after shot _____

Gas _____ Cu. Ft.

Dry Hole _____

Abandoned _____

Date

6-5-35 192 _____ Scout