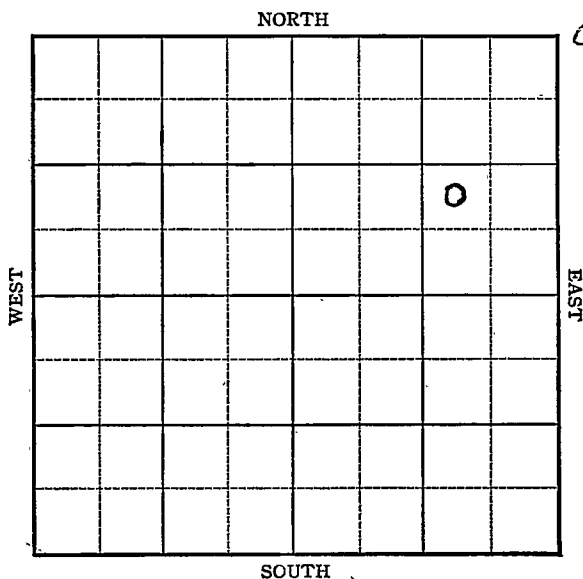


KANSAS

McPherson

Section 23 Township 17 Range 1WWell No. 3 BeckerCompany Phil-Han

KANSAS

McPherson County

Sec. 23 Twp. 17 R. 1W

Well No. #3 Becker Farm

Phil-Han Company


Crowther

Ft. from N. Line

990 Ft. from S. Line

990 Ft. from E. Line

Ft. from W. Line

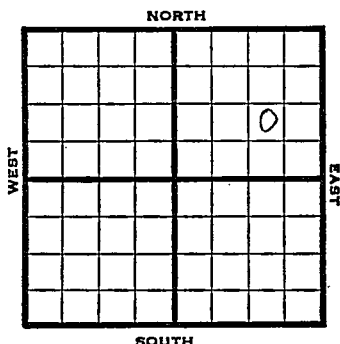

NW SE NE

1946 Elev. 1508 REPORT

5/1	8" @ 240
	Drlg. 1050'
5/7	Drlg 2580'
5/14	TD 2684 loc. hole
	Skidding 12' North
	8" @ 2 48
	Drlg 8445'
5/21	Chat 2822-
	2825 TD
	7" @ 2822 RUST
5/29	" " "
6/5	" " "
6/12	" " "
6/18	" " "
6/26	SW 1/4 1:00" "
7/3	" " "
7/10	Miss. 2822
	7" @ 2822
	7000 acid.
	TD 2825
	Echo Pot. 2822 oil plus 4% wtr.
	Grav. 37.0

COMPLETED

KANSAS Kansas Pool Name Cr'owtherMap No. 22 Sec. 23 Twp. 17 R. 1WWell No. 3 BeckerPhil-Han CompanyFIRST REPORT Contractor.

NW SE NE

SECTION PLAT

			o

 Ft. from N. Line990 Ft. from S. Line990 Ft. from E. Line Ft. from W. LineMcPherson County

RECORD

Location Cased in., ft.Rig up Sand

Drilling and Remarks:

Gas

8" @ 240

Oil

drlg. 1050

Total Depth

PRODUCTION

1st 24 hrs. Nat. 1st 24 hrs. after shot Gas Cu. Ft.Dry Hole Abandoned

Date

MAY 1 1946 19S. J. LEWIS Scout

KANSAS Kansas Pool Name Crowther PoolMap No. 22 Sec. 23 Twp. 17 R. 1WWell No. 3 BeckerPhil-Han Company**COMPLETED**

Contractor

NW SE NE

E. 1508
SECTION PLAT

			4

 Ft. from N. Line990 Ft. from S. Line990 Ft. from E. Line Ft. from W. LineMcPherson CountyLocationRig upDrilling and Remarks:

Miss 2822
7" @ 2822
7000 cuil
Ec to Rd 2822 oil
74 2/3 W
37 2/3 W

RECORDCased in., ft.Sand Gas Oil Total Depth 2825**PRODUCTION**1st 24 hrs. Nat. 1st 24 hrs. after shot Gas Cu. Ft.Dry Hole Abandoned

Date

JUL 10 1946 19S. J. LEWIS Scout