

ANSAS


McPherson

FORM 51 5M PETROL

Section 23- Township 17 Range 1W

Well No. 1-Burch
#2 Crowther "B"

Company Westgate-Greenland
Crowther Pool

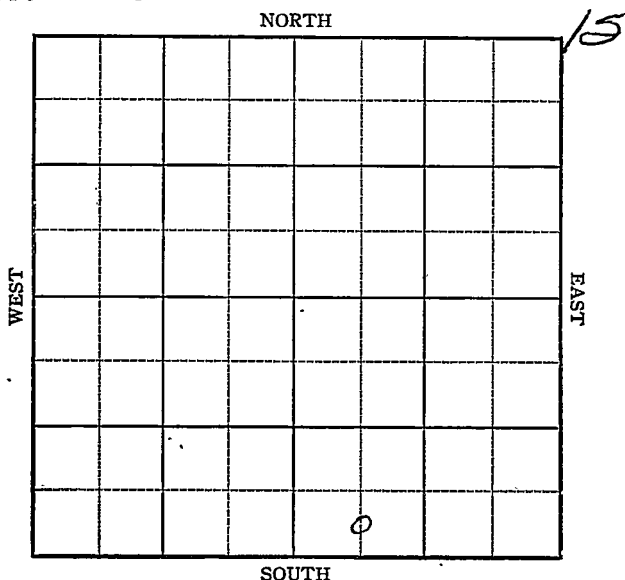


KANSAS

Sec. 23 Twp. 17 R. 1-W

Well No. 1 BURCH
#2, Crowther "B" Farm

Westgate-Greenland Company

NORTH

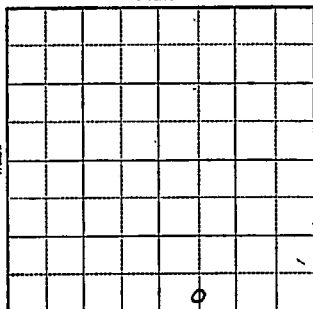

SOUTH

 Ft. from N. Line

330 Ft. from S. Line

 Ft. from E. Line

660 Ft. from W. Line

R E P O R T

1043

12/15

Location

12/22

Surface hole

12/29

10" @ 140 Drlg 560'

1944

1-5

Chat 2801-16 TD

SSO 7" @ 2810 RUST

1-12

TD 2816

5" @ 2809 RUST

1/19

TD 2822-2600' oil 100' water in 12 hr

1/26

7" @ 2810

Chat 2801

TD 2822

Pump 436oil

Gravity 33

COMPLETED

KANSAS

Map No. 42 Sec. 23 Twp. 17 R. 1WWell No. 2 Crowther "B"Westgate-Greenland Company

FIRST REPORT

Contractor

C S L SW SE

SECTION PLAT

Ft. from N. Line

330

Ft. from S. Line

Ft. from E. Line

660

Ft. from W. Line

Crowther Pool

Location X

Rig up

Drilling and Remarks:

RECORD

Cased _____ in., _____ ft.

Sand _____

Gas _____

Oil _____

Total Depth _____

PRODUCTION

1st 24 hrs. Nat. _____

1st 24 hrs. after shot _____

Gas _____ Cu. Ft.

Dry Hole _____

Abandoned _____

Date

DEC 15 1943

19

S. J. LEWIS Scout

KANSAS

Map No. 42 Sec. 23 Twp. 17 R. 1WWell No. 1 BurchWestgate-Greenland


Company

CORRECTION

Contractor

C S L SW SE

SECTION PLAT

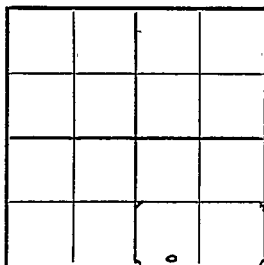

_____ Ft. from N. Line

330 Ft. from S. Line

_____ Ft. from E. Line

660 Ft. from W. Line

Crowther Pool

Location _____

Rig up _____

Drilling and Remarks:

Reported

#2 Crowther "B"

RECORD

Cased _____ in., _____ ft.

Sand _____

Gas _____

Oil _____

Total Depth _____

PRODUCTION

1st 24 hrs. Nat. _____

1st 24 hrs. after shot _____

Gas _____ Cu. Ft.

Dry Hole _____

Abandoned _____

Date

DEC 22 1943 19

S. J. LEWIS

Scout

KANSAS

Map No. 72 Sec. 23 Twp. 17 R. 1WWell No. #1 BurchWestgate-Greenland Company

COMPLETED

Contractor

C S L SW SE

SECTION PLAT

 Ft. from N. Line330 Ft. from S. Line Ft. from E. Line660 Ft. from W. Line

Crowther Pool

Location Rig up

Drilling and Remarks:

*Chas 2801**9" @ 2870**Pump 436 oil**33 2/3*

RECORD

Cased in., ft.Sand Gas Oil Total Depth 2832

PRODUCTION

1st 24 hrs. Nat. 1st 24 hrs. after shot Gas Cu. Ft.Dry Hole Abandoned

Date

JAN 26 1944 19

S. J. LEWIS Scout