

KANSAS


McPherson

FORM 51 5M PETROL

Section 23 Township 17 Range 1W

Well No. 2 M. Crowther

Company Westgate-Greenland

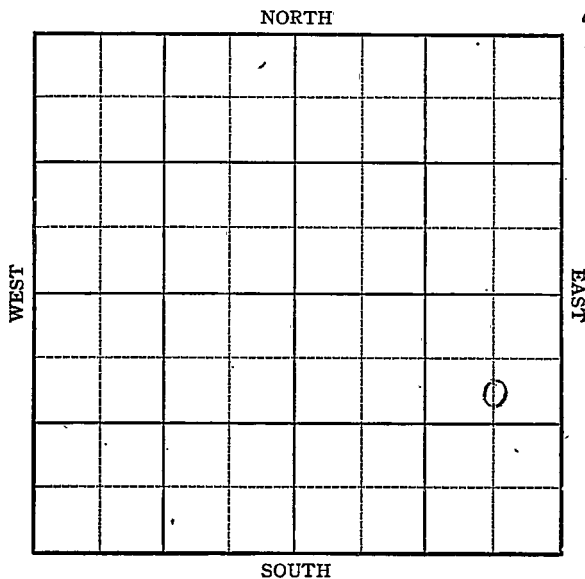

KANSAS

McPherson County

Sec. 23 Twp. 17 R. 1W

Well No. 2 M. Crowther Farm

~~Westgate-Greenland~~ Company


Crowther

990 Ft. from N. Line

Ft. from S. Line

660 Ft. from E. Line

Ft. from W. Line

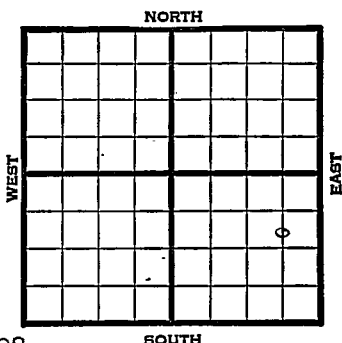

C S L NE SE Elev. 1508

1945

REPORT

5/2 Location
5/10 10" @ 149' WOC
5/17 Drlg. 2200
5/24 Lāns 2230
Miss 2806
TD 2820
7" @ 2815' RUST
5/31 " " " " "
6/8 TD 2836 - 1500' N plus 600' oil
PB
6/14 PB 2832-1000 acid
Temp Pot 83 oil & 85% w.
6/21 " " " "
6/28 " " " "
7/3 " " " "
7/11 " " " "
7/19 " " " "
7/26 " " " "
8/1 Miss 2806
7" @ 2815'
T.D. 2836'
P.B. 2832'
1000 acid
Pump 83 oil plus 85% water Pot.
Gravity 36.3

COMPLETED

Kansas Pool Name CrowtherMap No. 42 Sec. 23 Twp. 17 R. 1WWell No. 2 M. CrowtherWestgate-Greenland Company

FIRST REPORT

Contractor

C S L N E S E

SECTION PLAT

990 Ft. from N. Line Ft. from S. Line660 Ft. from E. Line Ft. from W. Line

McPherson County

Location XRig up

Drilling and Remarks:

RECORD

Cased in., ft.Sand Gas Oil Total Depth

PRODUCTION

1st 24 hrs. Nat. 1st 24 hrs. after shot Gas Cu. Ft.Dry Hole Abandoned

Date

MAY 2 1945 19 S. J. LEWIS Scout

KANSAS

Pool Name Crowther

Kansas

Map No. 42 Sec. 23 Twp. 17 R. 1WWell No. 2 M. CrowtherWestgate-Greenland Company

COMPLETED

Contractor

C S L NE SE

E 1.1508
SECTION PLAT990 Ft. from N. Line Ft. from S. Line660 Ft. from E. Line Ft. from W. Line

			0

McPherson County

Location Rig up

Drilling and Remarks:

*Miss 2806**7" C 2875**PB 2832.**1000 acres**Pump 83 oil + 85% water**BT**36 3/4*

RECORD

Cased in., ft.Sand Gas Oil Total Depth 2836'

PRODUCTION

1st 24 hrs. Nat. 1st 24 hrs. after shot Gas Cu. Ft.Dry Hole Abandoned

Date

AUG 1 1945 19S. J. LEWIS Scout