

KANSAS


FORM 51 5M 11-44 PETROL

McPherson County

Section 23 Township 17 Range 1W

Well No. #2 Blaine "A"

Company Westgate-Greenland

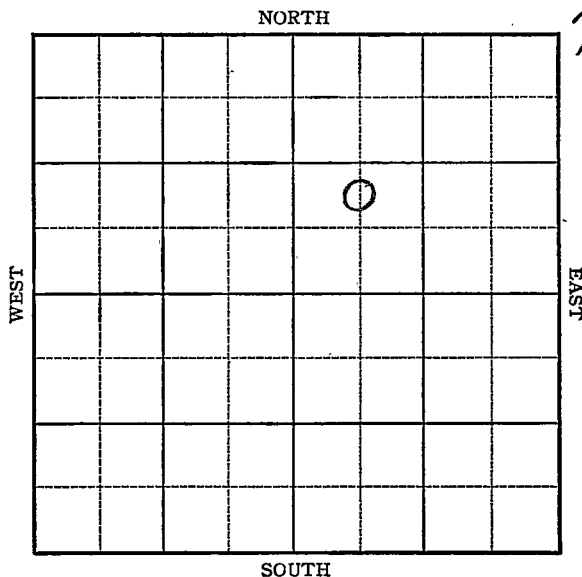

KANSAS

McPherson County

Sec. 23 Twp. 17 R. 1W

Well No. #2 Blaine "A" Farm

Westgate-Greenland

Company

Growth


 Ft. from N. Line

990 Ft. from S. Line

 Ft. from E. Line

660 Ft. from W. Line

CNL SW NE

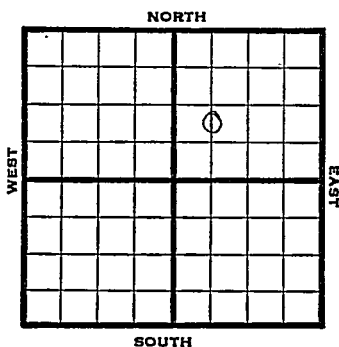

1946	REPORT
	Elev. <u>1471</u>
<u>2/13</u>	RUR
<u>2/21</u>	8" - 159'
	Drlg. 871'
<u>2/28</u>	Lans. 2190' Miss 2769-80' T.D.
	5" - 2778' RUST.
<u>3/6</u>	Miss. 2769
	5" @ 2778
	4000 acid.
	TD 2793'
	Depth Pot. 2072
	Grav. 36.0
	COMPLETED

Kansas Pool Name Crowther

KANSAS

Map No. 42 Sec. 23 Twp. 17 R. 1WWell No. 2 Blaine "A"Westgate-Greenland Company

FIRST REPORT

C N L SW NE Contractor

SECTION PLAT

		o	

 Ft. from N. Line

990

 Ft. from S. Line Ft. from E. Line

660

 Ft. from W. Line

McPherson County

Location Rig up

Drilling and Remarks:

RUR

RECORD

Cased in., ft.Sand Gas Oil Total Depth

PRODUCTION

1st 24 hrs. Nat. 1st 24 hrs. after shot Gas Cu. Ft.Dry Hole Abandoned

Date

FEB 13 1946

19

S. J. LEWIS

Scout

KANSAS Kansas Pool Name CrowtherMap No. 42 Sec. 23 Twp. 17 R. 1WWell No. 2 Blaine "A"Westgate-Greenland Company**COMPLETED**

Contractor

C N L SW NE

E1, 1471
SECTION PLAT

		o	

 Ft. from N. Line990 Ft. from S. Line Ft. from E. Line660 Ft. from W. Line

McPherson

Location Rig up

Drilling and Remarks:

Miss 2767
5" @ 2778
4000 acid
Sept 15 to 20 1972

*126 @ 2778***RECORD**Cased in, ft.Sand Gas Oil Total Depth 2793**PRODUCTION**1st 24 hrs. Nat. 1st 24 hrs. after shot Gas Cu. Ft.Dry Hole Abandoned

Date

MAR 6 1946 19 S. J. LEWIS Scout