


Section 23 Township 17 Range 1W

Well No. #3, Blaine "A"

Company Westgate-Greenland

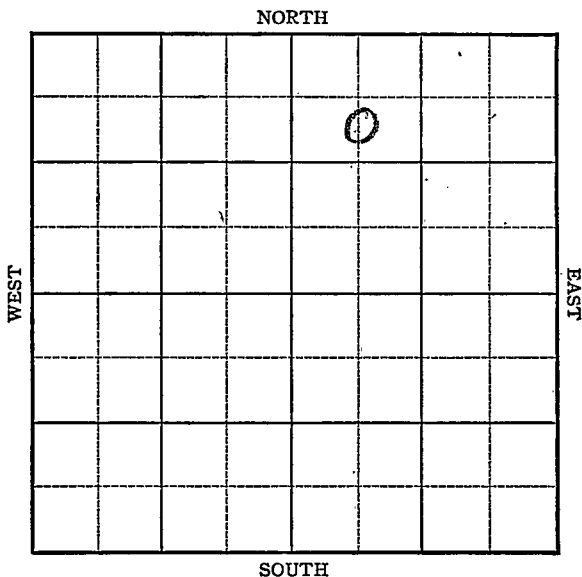


Sec. 23 Twp. 17 R. 1WWell No. #3 Blaine "A" FarmWestgate-Greenland Company

Crowther

990 Ft. from N. Line Ft. from S. Line Ft. from E. Line660 Ft. from W. Line

CSL NW NE

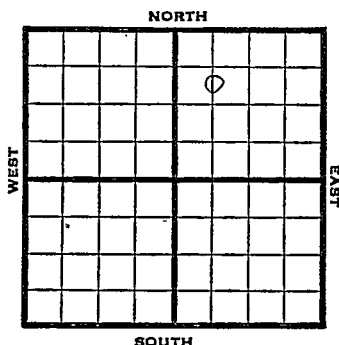

1946 Elev. 1419 REPORT

3/27 Location

4/4 RUR

4/10 8" @ 134
Drlg 27054/16 Lans 2210
Miss 2793
TD 2804 5" @ 2800 RUST


4/23 " " "

5/1 TD 2814
500 acid5/8 Miss. 2793
5" @ 2800
500 acid.
TD 2814
Pump 363 Pot.
Grav. 36.0

COMPLETED

Kansas Pool Name CrowtherMap No. KANSAS Sec. 23 Twp. 17 R. 1WWell No. 3 Blaine "A"Westgate-Greenland CompanyFIRST REPORT Contractor

C S L NW NE

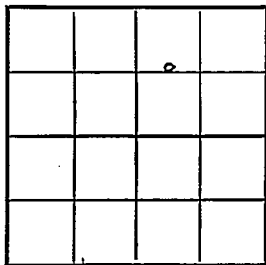SECTION PLAT¹¹990 Ft. from N. Line Ft. from S. Line Ft. from E. Line660 Ft. from W. LineMcPherson CountyLocation XRig up

Drilling and Remarks:

RECORD

Cased in., ft.Sand Gas Oil Total Depth

PRODUCTION

1st 24 hrs. Nat. 1st 24 hrs. after shot Gas Cu. Ft.Dry Hole Abandoned

Date

MAR 27 1946 19S. J. LEWIS Scout

KANSASKansas Pool Name CrowtherMap No. 42 Sec. 23 Twp. 17 R. 1WWell No. 3 Blaine "A"Westgate-Greenland Company**COMPLETED**

Contractor

C S L NW NE

E11419
SECTION PLAT990 Ft. from N. Line Ft. from S. Line Ft. from E. Line660 Ft. from W. Line

McPherson CountyLocation Rig up

Drilling and Remarks:

Wells 2793
5" @ 2800
500 acid
Pump 363 BT

*36° SW***RECORD**Cased in., ft.Sand Gas Oil Total Depth 2814**PRODUCTION**1st 24 hrs. Nat. 1st 24 hrs. after shot Gas Cu. Ft.Dry Hole Abandoned

Date

MAY 8 1946 19

S. J. LEWIS Scout