


Map No. 7 KANSAS Sec. 23 Twp. 17 R. 9W
 Well No. 4 Deer Truss Co. Farm _____ Company _____

NORTH

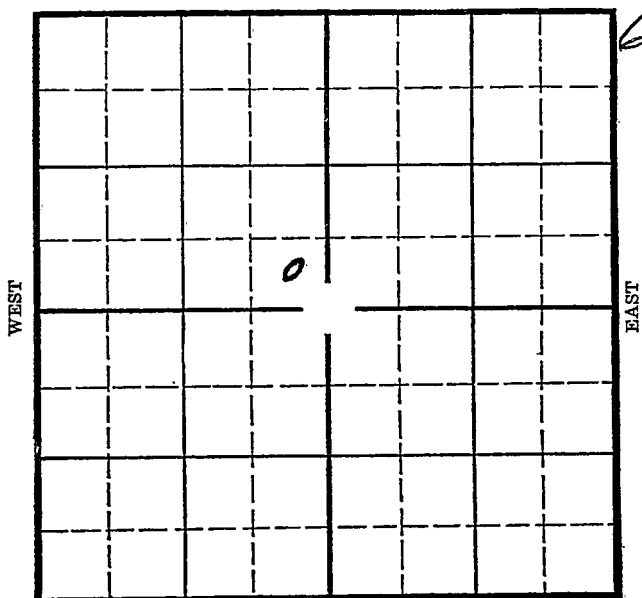

SOUTH

O. W. P. B.

Location _____
 Drilling Remarks _____

Rig Up _____
 Drilling Remarks _____

RECORD

Cased _____ in. _____ ft.
 Sand _____
 Gas _____
 Oil _____
 Total Depth _____

PRODUCTION

1st 24 hrs. Nat. _____
 1st 24 hrs. after shot _____
 Gas _____ cu. ft. _____
 Dry Hole _____
 Abandoned _____

Ellsworth
17 9W

Map No. KANSAS Sec. 23 Twp. 17 R. 9W

Well No. 4- Deer Farm
Lyons Co. Company


 Ft. from N. Line

330 Ft. from S. Line

330 Ft. from E. Line

 Ft. from W. Line

Elev. 1779

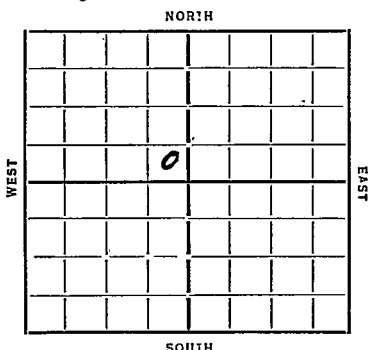

Date	REPORT	O. W. P. B.
1935		
8/21	Location	
8/29	Cellar	
9/6	Rig	
10/3	Set 3203-06 Run 7" 3201	
10/10	Drilling	
10/24	Set 3203	
	T.D. 3209	
	500 acid	
	745 lib	
	730 % Water	
	COMPLETED	
1939		O. W. P. B.
7/19	Old T.D. 3209'	
	P. B. to 3207'	
	SWD	
7/27	No report.	
8/3	Drilg. 3635'	
8/10	Drilg. 3895'	
8/17	T.D. 4100' Run liner.	

OVER

1939

8/24 TD 4100'
Run liner.

8/30 345' of 5" liner at 3300'
T.D. 4100'
Input 200-bbls. water per hour.
SALT WATER DISPOSAL WELL.

ABANDONED

KANSAS

Map No. 45 Sec. 23 Twp. 17 R. 9wWell No. 4-DeerTexas Co Company

Contractor

FIRST REPORTS

Ft. from N. Line

330 Ft. from S. Line330 Ft. from E. Line

Ft. from W. Line

SECTION PLAT

Location ✓

Rig up

Drilling and Remarks:

RECORD

Cased in, ft.

Sand

Gas

Oil

Total Depth

PRODUCTION

1st 24 hrs. Nat.

1st 24 hrs. after shot

Gas Cu. Ft.

Dry Hole

Abandoned

Date

8-21-32 192**ORVAL MANNSCHRECK**

Scout

KANSAS

Map No. 218 Sec. 23 Twp. 17 R. 9WWell No. 4-DesTexas Company Company

Contractor

COMPLETED**SECTION PLAT**

Ft. from N. Line

330 Ft. from S. Line330 Ft. from E. Line

Ft. from W. Line

	0		

Location.....

Rig up.....

Drilling and Remarks:

500 and745 oil+ 30% W**RECORD**

Cased.....in.....ft.

Sand oil 3203

Gas.....

Oil.....

Total Depth 3209**PRODUCTION**

1st 24 hrs. Nat.....

1st 24 hrs. after shot.....

Gas.....Cu. Ft.

Dry Hole.....

Abandoned.....

Date

10-24-35 192

ORVAL MANNSCHRECK

Scout

Map No. 45 Sec. 23 Twp. 17 R. 9WWell No. 4 DeesTexas

Company

Contractor

FIRST REPORT

SE NW

SECTION PLAT

Ft. from N. Line

330 Ft. from S. Line330 Ft. from E. Line

Ft. from W. Line

LORRAINE POOL

Location

Rig up

Drilling and Remarks:

OWD- 3209

PB 3207

SWD

RECORD

Cased _____ in., _____ ft.

Sand _____

Gas _____

Oil _____

Total Depth _____

PRODUCTION

1st 24 hrs. Nat. _____

1st 24 hrs. after shot _____

Gas _____ Cu. Ft.

Dry Hole _____

Abandoned _____

Date

JUL 19 1939

19

S. J. LEWIS

Scout

Map No. 45 Sec. 23 Twp. 17 R. 9WWell No. 4 Dies.Texas CompanySE NW Contractor~~ABANDONED~~

SECTION PLAT

 Ft. from N. Line330 Ft. from S. Line330 Ft. from E. Line Ft. from W. LineLorraine PoolLocation Rig up

Drilling and Remarks:

345' 5" liner
@ 3300In put 200 x 46
per hr.BWD

RECORD

Cased in., ft.Sand Gas Oil Total Depth 4100

PRODUCTION

1st 24 hrs. Nat. 1st 24 hrs. after shot Gas Cu. Ft.Dry Hole Abandoned

Date

AUG 30 1939S. J. LEWIS Scout