


Give All Information Completely
Make Required Affidavit
Mail or Deliver Report to:
Conservation Division
State Corporation Commission
211 No. Broadway
Wichita, Kansas

WELL PLUGGING RECORD

NORTH

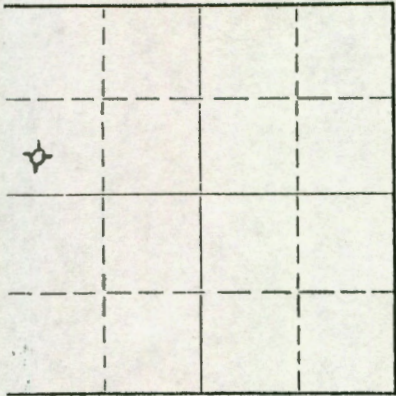

Locate well correctly on above
Section Plat

Ness

County. Sec. 17 Twp. 17S Rge. 24W (E) (W)

Location as "NE/CNWKSW" or footage from lines. C SW/4 NW/4

Lease Owner Walters Drilling Co.

Lease Name DICKMAN Well No. 5

Office Address 510 Orpheum Building, Wichita 2, Kansas

Character of Well (completed as Oil, Gas or Dry Hole) Dry Hole

Date well completed December 14th 19 62

Application for plugging filed December 14th 19 62

Application for plugging approved December 14th 19 62

Plugging commenced December 14th 19 62

Plugging completed December 14th 19 62

Reason for abandonment of well or producing formation

If a producing well is abandoned, date of last production 19

Was permission obtained from the Conservation Division or its agents before plugging was commenced? Yes, verbal approval

Name of Conservation Agent who supervised plugging of this well Eldon Petty

Producing formation Mississippian Depth to top Bottom Total Depth of Well 4470 Feet

Show depth and thickness of all water, oil and gas formations.

OIL, GAS OR WATER RECORDS

CASING RECORD

FORMATION	CONTENT	FROM	TO	SIZE	PUT IN	PULLED OUT
				8-5/8"	114'	-0-

Describe in detail the manner in which the well was plugged, indicating where the mud fluid was placed and the method or methods used in introducing it into the hole. If cement or other plugs were used, state the character of same and depth placed, from feet to feet for each plug set.

Run plug with 11 stands pipe. Cement w/20 sacks through drill pipe. Set second plug @ 180 ft. with 1/2 sack hulls and 20 sacks cement through pipe. Set top plug @ 35 ft. with hulls and 10 sacks cement. Job complete at 12:00 PM - 12-14-62.

(If additional description is necessary, use BACK of this sheet)

Name of Plugging Contractor Walters Drilling Co.
Address 510 Orpheum Building, Wichita, Kansas

STATE OF KANSAS, COUNTY OF Sedgwick, ss.
Robert F. Walters

I, (Signature) or (owner or operator) of the above-described well, being first duly sworn on oath, says: That I have knowledge of the facts, statements and matters herein contained and the log of the above-described well as filed and that the same are true and correct. So help me God.

(Signature) Robert F. Walters
ROBERT F. WALTERS, Partner
510 Orpheum Building, Wichita, Kansas
(Address)

SUBSCRIBED AND SWORN TO before me this 7th day of January, 19 63

My commission expires January 4th, 1964.
R. L. Abel
Notary Public.