


Ellsworth

KANSAS

SECTION 24 TOWNSHIP 17S RANGE 10W

WELL NO. #1 Stumps "B"

COMPANY Buick Drlg. Co.

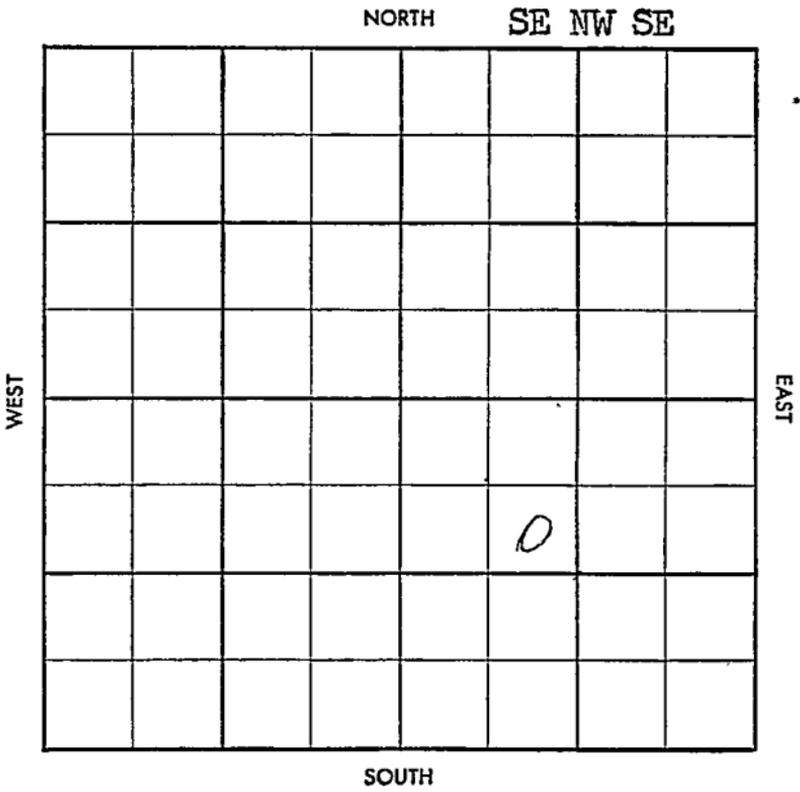



Typ    Pool   

Co.    Facet   

S-513-B

County Ellsworth Elev. 177 1777  
Sec. 24 Twp. 17 Rge. 10W  
Company Buick Drlg. Co.  
Farm Name Stumps "B" No. 1

TOPS	DEPTH	LOG	DATUM	Loc. in Sec.
Anh.	<u>494</u>			<u>SE NW SE</u>
Tp.				
H.	<u>2769</u>			
Tr.				
Dg.				
B.L.	<u>2886</u>			<u>Hop Py rot</u>
L.	<u>2900</u>			Geol. <u>Py rot</u>
K.C.				Contr. <u>  </u>
B.K.C.	<u>3152</u>			<u>Co. Tools</u>
Ce.				Pool <u>  </u>
C.				<u>Stoltenberg</u>
M.	<u>3162</u>			
<u>L</u> M.	<u>3208</u>			
K.				
Mz.				
Mq.				
V.				
S.				
S.				
A.	<u>3234</u>			<b>ABANDONED</b>
R.				
Pf.				
G.				<u>a</u>
T.D.	<u>3256</u>			<u>JUL 9 '58</u>

Date Comm. 6-17-58 8" 239  
8" @ 235 w/spudder - RURT JUN 18 '58 JUN 25 '58  
JUL 2 '58 Circ 3405 JUL 9 '58 no log

D&A