


Ellsworth

Form 252-A
5M 4-32 MPC

Map No. **KANSAS** Sec. ²⁴~~23~~ Twp 17 R. 10^w

Well No. 1 Wilkins "A" lease Farm
Slick-Pryor & Lockhart Company

330 Ft. from N. Line
-
Ft. from S. Line
330 Ft. from E. Line
Ft. from W. Line

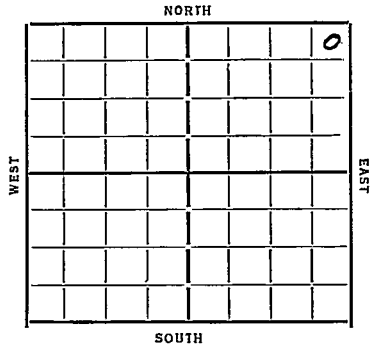

Date	REPORT
7/9/34	
5/30	Cellar
6/7	—
6/14	Spud
6/21	dly 1375 15" 318 13" 494
6/28	" 2250 10" 1945
7/5	" 2800 8" 2602
7/12	A.O. 3185-90 5" 3223
	N.R. 5" 3238
7/19	oil 3233 A.O. 3238 A.O. 3260
	TD 3266 147N PB.
7/26	PB 3263
8/2	— 8/9 —
8/16	10 qt shot 1200' fluid
	1000 acid
8/23	Pump 20 oil 300 W.
8/30	—
9/5	Silicious 3233 TD 3266 D+FA

ABANDONED

Blair

Map No. 55 Sec. 24 Twp. 17 R. 10W

Well No. 1 - Wilkins 'a' Lease

Slick-pyow + Lockhart Company

Contractor

CORRECTION

SECTION PLAT

			0

330 Ft. from N. Line

_____ Ft. from S. Line

330 Ft. from E. Line

_____ Ft. from W. Line

CORRECTION

Location _____

Rig up _____

Drilling and Remarks:

*cellar
formerly reported
as section 23*

RECORD

Cased _____ in., _____ ft.

Sand _____

Gas _____

Oil _____

Total Depth _____

PRODUCTION

1st 24 hrs. Nat. _____

1st 24 hrs. after shot _____

Gas _____ Cu. Ft.

Dry Hole _____

Abandoned _____

CORRECTION

Date

5-31-34₁₉

ORVAL MANNSCHRECK

Scout

Map No. NCA Sec. 28 Twp. 17 R. 10N

Well No. 1 Wilkins "A" Lease

Glick-Payor & Trekhart Company
Contractor

SECTION PLAT

			0
FIRST REPORTS			

220 Ft. from N. Line

_____ Ft. from S. Line

220 Ft. from E. Line

_____ Ft. from W. Line

Location _____

Rig up _____

Drilling and Remarks:

Cellar

RECORD

Cased 1 in., _____ ft.

Sand _____

Gas _____

Oil _____

Total Depth _____

PRODUCTION

1st 24 hrs. Nat. _____

1st 24 hrs. after shot _____

Gas _____ Cu. Ft.

Dry Hole _____

Abandoned _____

Date

5/30 1934

Scout

Edwards

Map No. 55 Sec. 24 Twp. 17 R. 10W

Well No. 1 - Wilkins "A"

Slick, Pryor & Lockhart Company

Contractor

ABANDONED

SECTION PLAT

330 Ft. from N. Line

_____ Ft. from S. Line

330 Ft. from E. Line

_____ Ft. from W. Line

Location _____

Rig up _____

Drilling and Remarks:

10V A

RECORD

Cased _____ in., _____ ft.

Sand siliceous 3733

Gas _____

Oil _____

Total Depth 3266

PRODUCTION

1st 24 hrs. Nat. _____

1st 24 hrs. after shot _____

Gas _____ Cu. Ft.

Dry Hole _____

Abandoned _____

Date

9-5-31 19

ORVAL MANNSCHECK

Scout