


Ellsworth

Form 51-5M-11-31-Palace

Map No. KANSAS Sec. 24 Twp. 17 R. 10^W

Well No. 1-2-10-20 Farm

Smith & Ash et al Company

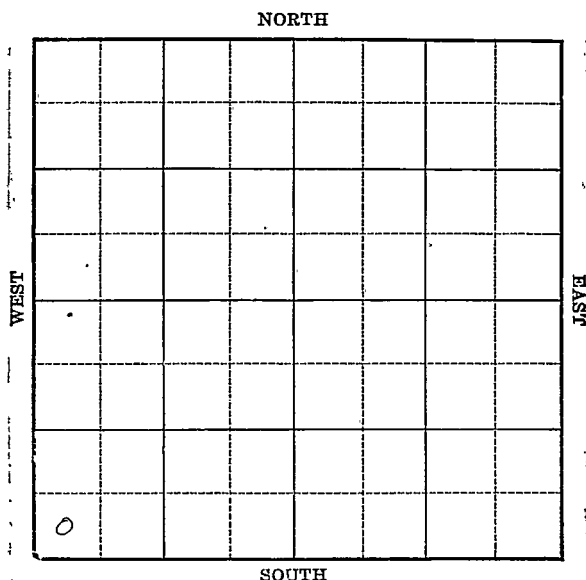

Location

Drilling Remarks

Rig Up

Drilling Remarks

RECORD

Cased in. ft.

Sand

Gas

Oil

Total Depth

PRODUCTION

1st 24 hrs. Nat.

1st 24 hrs. after shot

Gas cu. ft.

Dry Hole

Abandoned

Map No. KANSAS Sec. 24 Twp 17 R. 10th

Well No. 1 - Shoney Farm

Smith - Ash et al Company


 Ft. from N. Line

330 Ft. from S. Line

 Ft. from E. Line

330 Ft. from W. Line

1933

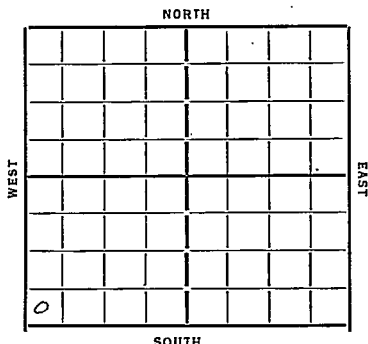

Date	REPORT
1/4	Flush pond
1/11	Rein. up.
1/18	Stop
1/25	Set 15" 305'
2/1	12" 487'
	Drill 950'
2/8	" 1400'
2/15	10" 1810'
	Drill 2110'
2/22	show gas 2147-50'
	Drill 2380'
3/4	1/2" gas 2511-17-8" 2526'
	Drill 2750'
3/8	6" - 3081' Drill 3090'
3/15	Long 3205-39' Siliceous 3239-69'
	1st show 3252 Pay 3267-69' 2000' oil
	6 hrs well swab
3/22	Sili Lume 3239-70'
	5" liner 3239 T.D. 3270
	1st show 3252 Pay 3267-69'
	pump 193 bbls 18 hours
	(Completed)

Ellsworth

 55 Map No. **KANSAS** Sec. 24 Twp. 17 R. 10

 Well No. 1 *Shoneyo*
Smith & Ash Co Company

Contractor

FIRST REPORTS

Ft. from N. Line

330 Ft. from S. Line

Ft. from E. Line

330 Ft. from W. Line

SECTION PLAT

Location

Rig up

Drilling and Remarks:

Shoneyo

RECORD

Cased.....in.,ft.

Sand.....

Gas.....

Oil.....

Total Depth.....

PRODUCTION

1st 24 hrs. Nat.....

1st 24 hrs. after shot.....

Gas.....Cu. Ft.

Dry Hole.....

Abandoned.....

Date

JAN 4 1933

CHAS. L. SHERWOOD

192

Scout

no wait

Returned	<i>[Signature]</i>
Cards	
Tracing	<i>[Signature]</i>
France Map	<i>[X]</i>
Scarborough Map	<i>[X]</i>
Moody Map	<i>[X]</i>
Scarborough Map Book	
Moody Map Book	

Ellsworth

W

55 KANSAS

Map No. Sec. 24 Twp. 17 R. 10

Well No. 1 Shomo

Smith & Ash Co. Company

Contractor

COMPLETED

SECTION PLAT

Ft. from N. Line

330 Ft. from S. Line

Ft. from E. Line

330 Ft. from W. Line

Location

Rig up

Drilling and Remarks:

5" liner 3239

1st show 3252

Pay 3267-69

Pump 193 bbls

18 Hours.

RECORD

Cased 4 in., 3081 ft.

Sand 511 L 3239-70

Gas

Oil

Total Depth 3270

PRODUCTION

1st 24 hrs. Nat.

1st 24 hrs. after shot

Gas Cu. Ft.

Dry Hole

Abandoned

Date

MAR 22 1933

CHAS. L. SHERWOOD

192

Scout

Small map
no wall map

Returned	
Cards	<i>[initials]</i>
Tracing	<i>[initials]</i>
France Map	<i>[initials]</i>
Scarborough Map	<i>[initials]</i>
Moody Map	<i>[initials]</i>
Scarborough Plot Book	
Moody Plot Book	