


Section 24 Township 17 Range 10W

Well No. #1 Stratman

Company J. H. Johnson

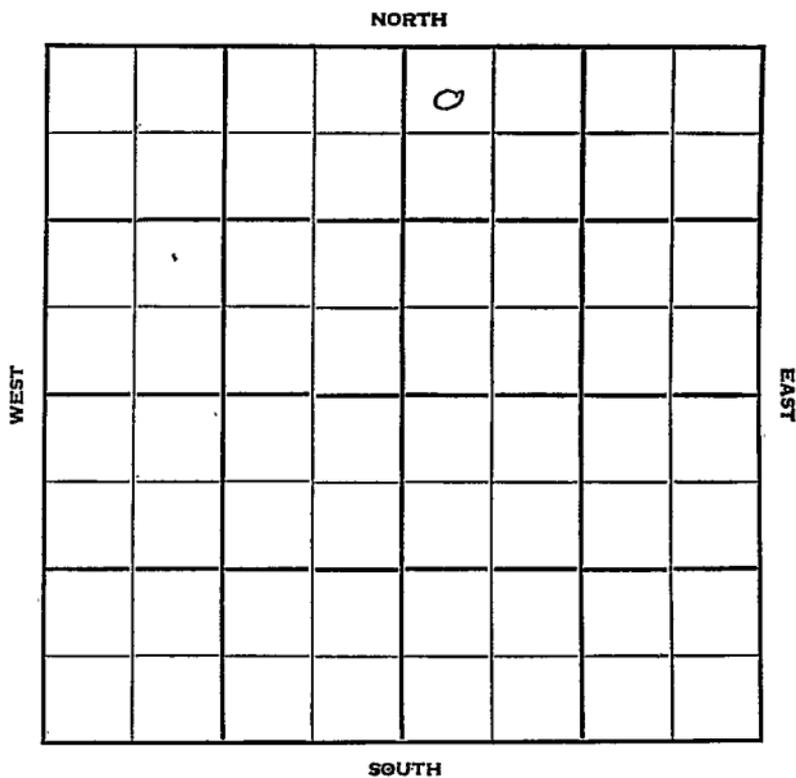

Sec. 24 Twp. 17 R. 10W

Well No. #1 Stratman Farm

J. H. Johnson Company

Contractor


330' Heiken N  
Ft. from N. Line

..... Ft. from S. Line

..... Ft. from E. Line

330' Ft. from W. Line

NW NW NE

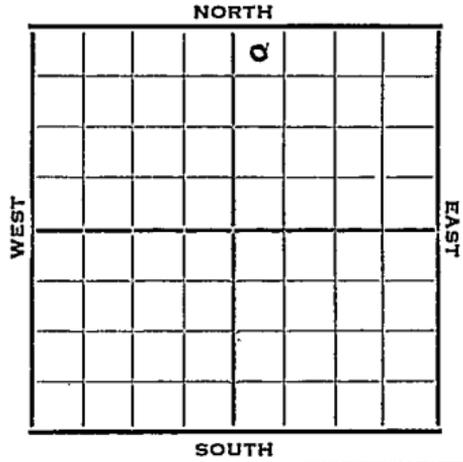

1952 Elev. 1765' REPORT

2/27 Surf set  
3/5 " "  
3/11 8" @ 205'  
Drlg. 2249'

3/19 Spud 3-6-52  
D&A TD 3250  
8" @ 205 Lans. 2876  
Arb. 3220  
DST 3220-32 opn 1/2 hr. Rec. 7' mud  
DST 3220-50 opn 1 hr. Rec. 10' socm  
TD 3250  
D&A

**ABANDONED**


County **Ellsworth** State **Kansas**

Sec. **24** (Blk. Twp.) **17** (Sur. Rge.) **10W** Map No.

Operator **J. H. Johnson**

Well No. **1** Farm **Stratman**

Elev. \_\_\_\_\_ Location **NW NW NE**

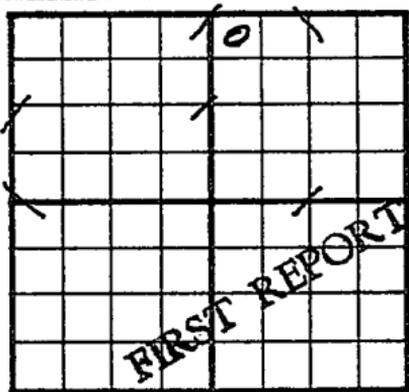

**330** Ft. From **N** Line **NE**

**330** Ft. From **W** Line **Quarter**

1st. Report **FEB 27 1952**

Completion \_\_\_\_\_

Remarks \_\_\_\_\_

Spudding Date \_\_\_\_\_

Drlg. Data **Heiken N**

**Surf set**


**J. G. McGEHEE**

County Ellsworth State Kansas  
 Sec. 24 (Blk. 17) (Sur. 10W) Map No.

Operator J. H. Johnson

Well No. 1 Farm Stratman

Elev. 1765 Location NW NW NE

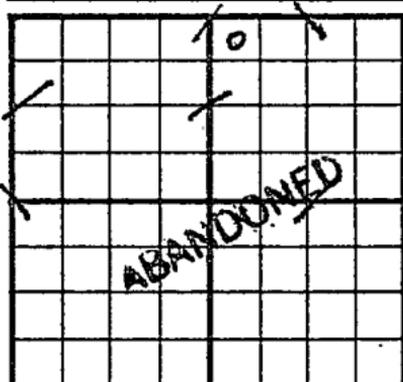

330 Ft. From N Line NE  
330 Ft. From W Line Quarter

Ist. Report \_\_\_\_\_  
 Completion MAR 19 1952  
 Remarks N. Heiken Pool

Spudding Date 3-6-52

Drlg. Data D & A TD 3250

8" @ 205 Lans. 2876 Arb. 3220

DST 3220-32 open 1/2 hr. Rec. 7' mud

DST 3220-50 open 1 hr. Rec. 10' socm

TD 3250

D & A