


Section 24 Township 17 Range 9 W

Well No. # 1 Melchert

Company Brooks-Pierce

NORTH

12

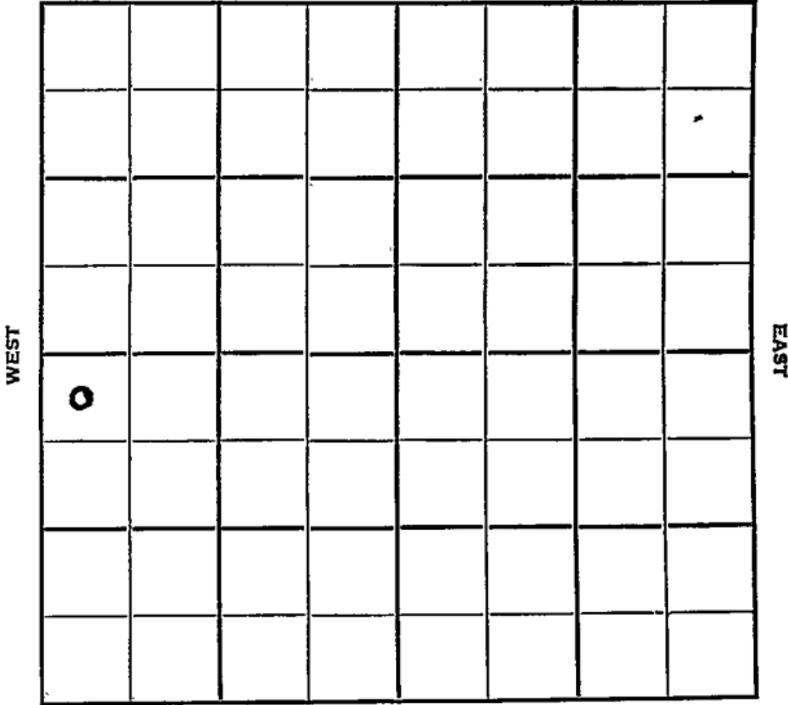

SOUTH

Ellsworth

KANSAS

Sec. 24 Twp. 17 R. 9W

Well No. #1 Melchert Farm

Brooks-Pierce Company

Contractor


330' Ft. from N. Line

_____ Ft. from S. Line

_____ Ft. from E. Line

330' Ft. from W. Line

NW NW SW

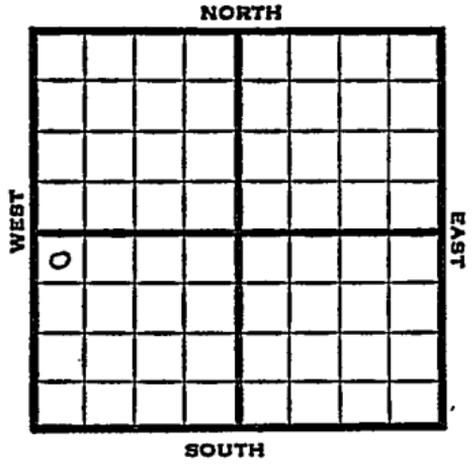

1951

Elev. 1798' REPORT

3/14

TD 3288 D&A

FIRST REPORT
ABANDONED

County Ellsworth State Kansas

Sec. 24 (Blk. Twp.) 17 (Sur. Rge.) 9W Map No.

Operator Brooks-Pierce

Well No. 1 Farm Melchert

Elev. 1798 Location NW NW SW

FIRST REPORT							
D							
ABANDONED							

330 Ft. From N Line SW

330 Ft. From W Line Quarter

1st. Report MAR 14 1951

Completion MAR 14 1951

Remarks _____

Spudding Date _____

Drlg. Data _____

TD 3288 D & A