

KANSAS

FORM 51 5M 10-41 PETROL

McPherson

Section 24 Township 17 Range 4-W

Well No. #3 Frantz

Company Dickey

NORTH

							1
				0			

SOUTH

WEST EAST

15

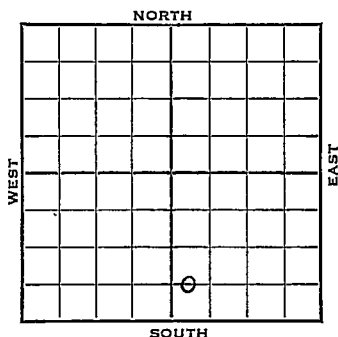
Sec. 24 Twp. 17 R. 4-WWell No. #3 Frantz FarmDickey Company

Lindsborg

Ft. from N. Line

660 Ft. from S. Line

Ft. from E. Line

330 Ft. from W. Line*Elev. 1359*

. 1943

REPORT

3/3 Location.
3/10 Rotary
3/17 "
3/24 Surface Hole
3/31 12" @ 167' 8" @ 378 Drlg. 1555
4/7 Miss 2968
Drlg. 3060'
4/14 Viola 3408 $\frac{1}{2}$
T.D. 3410 Sat
5" @ 3408 $\frac{1}{2}$ RUST.
4/21 T.D. 3414 $\frac{1}{2}$ -900' oil 7 hrs.
1500-acid swab 8 oil per hr
4/28 Viola 3408 $\frac{1}{2}$
5" @ 3408 $\frac{1}{2}$
T.D. 3414 $\frac{1}{2}$
3000 gal. acid
Pump 635 Pot.
Gravity 36

COMPLETED

KANSAS

Map No. 44 Sec. 24 Twp. 17 R. 4WWell No. 3 FrantzDickey

Company

FIRST REPORT

Contractor

C WL SW SE

SECTION PLAT

 Ft. from N. Line660 Ft. from S. Line Ft. from E. Line330 Ft. from W. Line

LINDSBORG POOL

Location XXXRig up

Drilling and Remarks:

RECORD

Cased in., ft.Sand Gas Oil Total Depth

PRODUCTION

1st 24 hrs. Nat. 1st 24 hrs. after shot Gas Cu. Ft.Dry Hole Abandoned

Date

MAR 3 1943S. J. LEWIS

Scout

McPherson

Map No. KANSAS Sec. 24 Twp. 17 R. 4WWell No. 3 FrantzDickey CompanyCOMPLETED Contractor

C WL SW SE

SECTION PLAT

		0	

 Ft. from N. Line660 Ft. from S. Line Ft. from E. Line330 Ft. from W. Line

LINDSBORG POOL

Location Rig up

Drilling and Remarks:

Vista 3408 1/25' to 3408 1/23000 BuailPump 635 P.D.36° S

RECORD

Cased in., ft.Sand Gas Oil Total Depth 3414 1/2

PRODUCTION

1st 24 hrs. Nat. 1st 24 hrs. after shot Gas Cu. Ft.Dry Hole Abandoned

Date

APR 28 1943 19

S. J. LEWIS Scout