


KANSAS

FORM 51 5M BRIX

Section 24 Township 17 Range 4W

Well No. #2 Frantz "B"

Company Stanolind

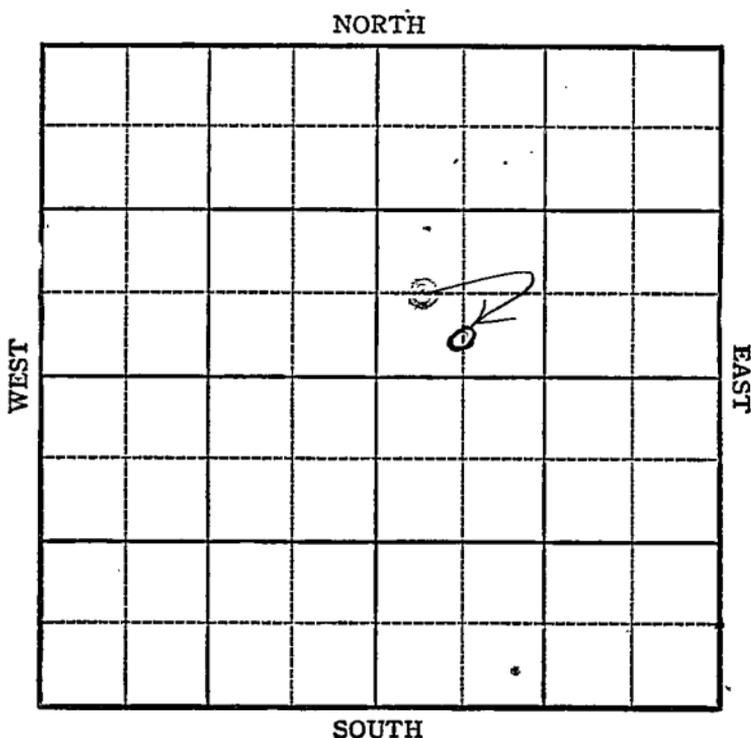

Sec. 24 Twp. 17S R. 4W

Well No. #2, Grantz "B" Farm
Stanolind Company


Lindsborg

330 Ft. from N. Line

660 Ft. from S. Line

660 Ft. from E. Line

330 Ft. from W. Line

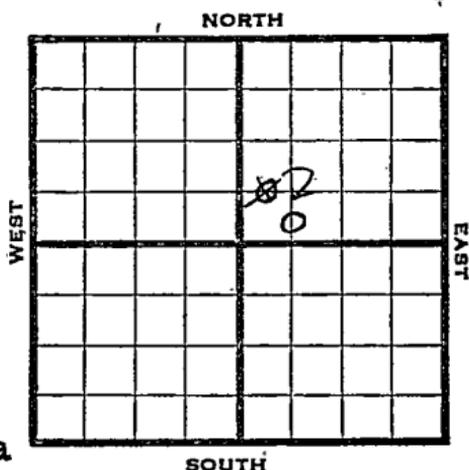

C S L SW NE

Was a
Dickey Lease

1945

REPORT 1945

1-10	Location
1/17	13" @ 157 WOC
1/26	8" @ 392' Drlg. 1050'
1/31	Drlg. 3060'
2/7	Lans 2314 Miss 2984 Viola 3482 Drlg 3493
2/14	TD 3518 5" @ 3503 RUST
2/21	" " " " " "
2/28	60 shots 3430-45 No shows 500 acid
3/7	1500 acid Swb 11 oil in 12 hrs
3/14	Miss 2984 Viola 3482 5" @ 3503 Perf. Miss 2000 acid. TD 3518 Pump 25 oil plus 22% water. Pot Grav. 36.0

COMPLETED

Pool Name LindsborgMap No. 44 Sec. 24 Twp. 17 R. 4WWell No. 2 Frantz "B"Starolind Company

FIRST REPORT Contractor

C W L SW NE

SECTION PLAT

 Ft. from N. Line660 Ft. from S. Line Ft. from E. Line330 Ft. from W. Line

		o	

McPhersonLocation XRig up

Drilling and Remarks:

Was a Dickey 1

RECORD

Cased in, ft.Sand Gas Oil Total Depth

PRODUCTION

1st 24 hrs. Nat. 1st 24 hrs. after shot Gas Cu. Ft.Dry Hole Abandoned

Date

JAN 10 1945 19S. J. LEWIS Scout

Pool Name Lindsborg

Map No. 44 Sec. 24 Twp. 17 R. 4W

Well No. 2 Frantz "B"

Stanolind Company

CORRECTION Contractor

C S L SW NE


SECTION PLAT

_____ Ft. from N. Line

330 Ft. from S. Line

_____ Ft. from E. Line

660 Ft. from W. Line

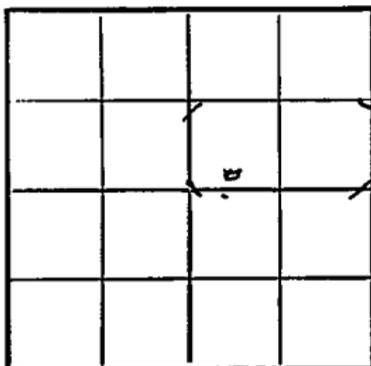

McPherson County

Location _____

Rig up _____

Drilling and Remarks:

Reported

C W L SW NE

RECORD

Cased _____ in., _____ ft.

Sand _____

Gas _____

Oil _____

Total Depth _____

PRODUCTION

1st 24 hrs. Nat. _____

1st 24 hrs. after shot _____

Gas _____ Cu. Ft.

Dry Hole _____

Abandoned _____

Date

JAN 17 1945 19 _____

S. J. LEWIS Scout

Pool Name Lindsborg

Map No. 44 Sec. 24 Twp. 17 R. 4W

Well No. 2 Frantz "B"

Stanolind

Company

COMPLETED

Contractor

C S L SW NE

SECTION PLAT

 Ft. from N. Line

330 Ft. from S. Line

 Ft. from E. Line

660 Ft. from W. Line

McPherson

Location

Rig up

Drilling and Remarks:

Mis 2984
Via 3472
5" 03503
Perf Mis
2000 acid
Pump 25 oil + 22%
Water Prod

RECORD

Cased in., ft.

Sand

Gas

Oil

Total Depth 3578

PRODUCTION

1st 24 hrs. Nat.

1st 24 hrs. after shot

Gas Cu. Ft.

Dry Hole

Abandoned

Date

36th Dec

MAR 14 1945 19

S. J. LEWIS

Scout