


Section 24 Township 17 Range 4-W

Well No. #1 Libjestrund

Company Dickey Oil

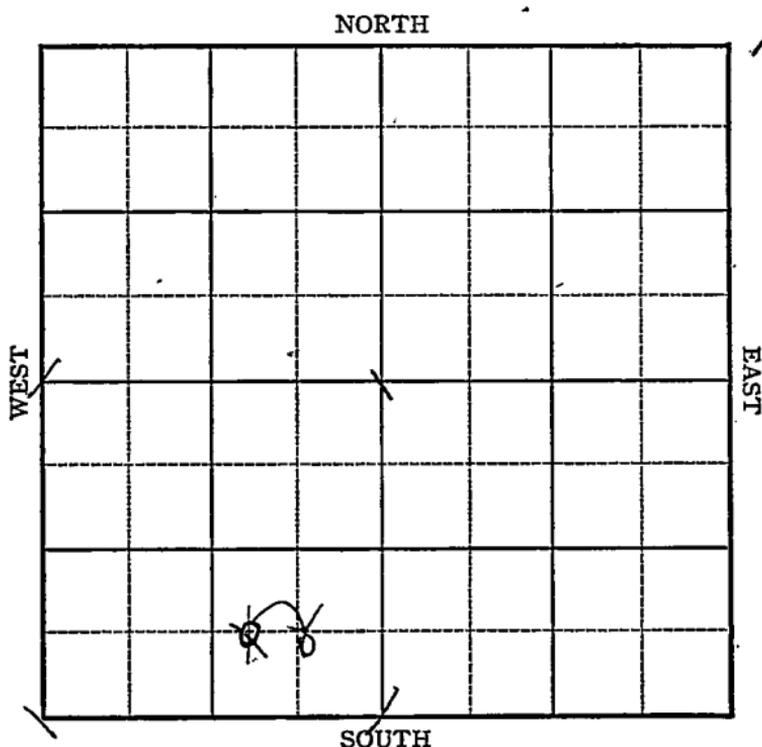

KANSAS

McPherson

Sec. 24 Twp. 17 R. 4-W

Well No. #1 Libjestrang Farm

Dickey-Oil Company

Lindsborg

 Ft. from N. Line


555

~~660~~ Ft. from S. Line

555

~~990~~ Ft. from E. Line

 Ft. from W. Line

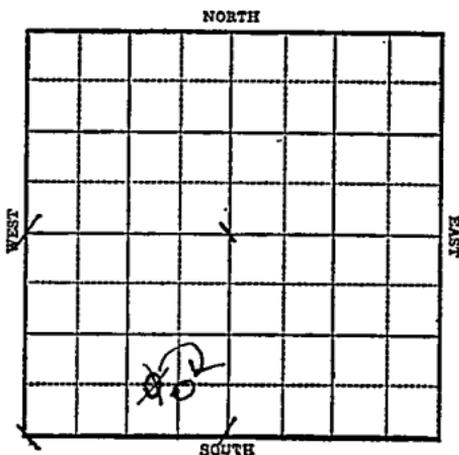

1943

Elev. 1366 R E P O R T

7/21

S.H.

7/28

8" @ 377

12" @ 138'

Drlg. 2010'

8/4

Miss 2977

Drlg. 3159

8/11

Viola 3419

5" @ 3414

T.D. 3419-1000' oil 6 hrs.

8/18

2500 acid no test.

8/25

Viola 3414

5" @ 3414

2500 acid

Pump 640 Pot.

T.D. 3419

Grav. 36.4

COMPLETED

KANSAS

Map No. 44 Sec. 24 Twp. 17 R. 4WWell No. 1 Libjestrang

Dickey Oil


Company

FIRST REPORT

Contractor

C W L SE SW

SECTION PLAT

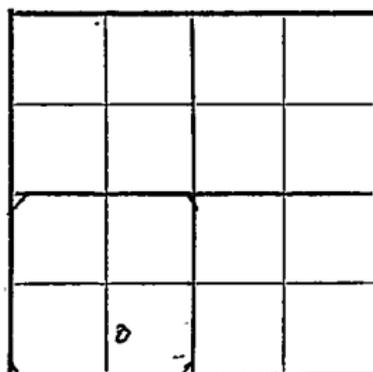 Ft. from N. Line660 Ft. from S. Line990 Ft. from E. Line Ft. from W. Line

LINDSBORG POOL

Location Rig up

Drilling and Remarks:

S.H.

RECORD

Cased in., ft.Sand Gas Oil Total Depth

PRODUCTION

1st 24 hrs. Nat. 1st 24 hrs. after shot Gas Cu. Ft.Dry Hole Abandoned

Date

JUL 21 1943

19

S. J. LEWIS

Scout

McPherson

Map No. KANSAS Sec. 24 Twp. 17 R. 4WWell No. 1 LiljestrandDickey Oil CompanyCORRECTION Contractor

C SE SW

SECTION PLAT

 Ft. from N. Line555 Ft. from S. Line555 Ft. from E. Line Ft. from W. Line

LINDSBORG POOL

Location Rig up

Drilling and Remarks:

Reported

C WL SE SW

RECORD

Cased in., ft.Sand Gas Oil Total Depth

PRODUCTION

1st 24 hrs. Nat. 1st 24 hrs. after shot Gas Cu. Ft.Dry Hole Abandoned

Date

AUG 4 1943 19S. J. LEWIS Scout

KANSAS

Map No. 44 Sec. 24 Twp. 17 R. 4W

Well No. 1 Lijestrang

Dickey Oil Company

COMPLETED Contractor

C SE SW

SECTION PLAT

_____ Ft. from N. Line

555 Ft. from S. Line

555 Ft. from E. Line

_____ Ft. from W. Line

	o		

Lindsborg Pool

Location _____

Rig up _____

Drilling and Remarks:

V. L. W. 3414
3" @ 3414
2500 Gall C
Pump 640 Pst.

36 4/8

RECORD

Cased _____ in., _____ ft.

Sand _____

Gas _____

Oil _____

Total Depth 3419

PRODUCTION

1st 24 hrs. Nat. _____

1st 24 hrs. after shot _____

Gas _____ Cu. Ft.

Dry Hole _____

Abandoned _____

Date _____