


O. W. P. B.Section 25 Township 17 Range 10WWell No. #1 BeckerCompany Graham-Messman-Rinehart Oil Co.

NORTH

WEST

EAST

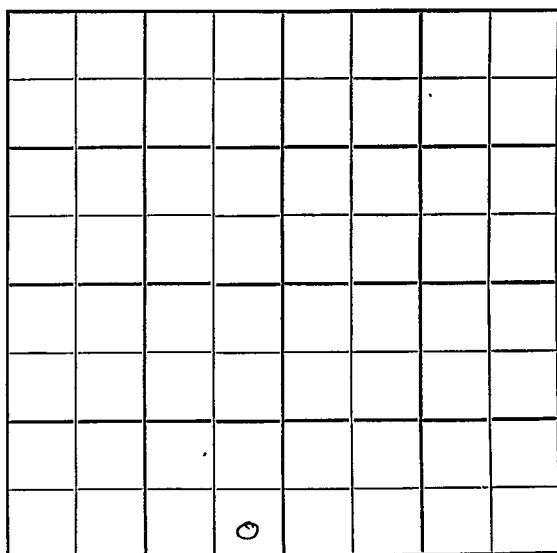

SOUTH

O. W. P. B. Ellsworth

KANSAS

Sec. 25 Twp. 17 R. 10W

Well No. #1 Becker Farm

Graham-Messman-Rinehart Oil Co. Company

Lohman & Johnson - Contr. Contractor
Heikan


 Ft. from N. Line

330' Ft. from S. Line

330' Ft. from E. Line

 Ft. from W. Line

SE SE SW

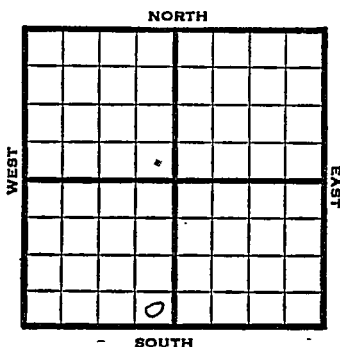

1951 Elev. 1778' REPORT

10/17 Spud 10-11-51
8" @ 250
Drlg. 2440'

12/5 Spud 10-11-51
Oil Well TD 3268
8" @ 250'
Ians. 2910
DST 2978-3007 open 1 Hr.
Rec. 1020' SMC0 75% free oil
Cong. 3217 Arb. 3264-68
5" @ 3265 CO to 3269
S/ $\frac{1}{2}$ BOPH 8 hr. 250 A
S/ 2 BOPH 12 hr. 500 A
S/ $2\frac{1}{2}$ BOPH 8 hr.
Comp. 243 BOPD 3% wtr.

COMPLETED

OVER

1953

11/4

Oil Well

TD 3268'

KC 2910', Cong 3217', Arb. 3264'

OTD 3268'

5" @ 3265'

SP 3260'

23/3252-56, S/15 go 4 gwph

40/3223-35, SP 3040

24/2987-93, SG 10 goph, 1000A

F/6 boph

Comp. 62 bopd

FIRST REPORT
✓
COMPLETED

County **Ellsworth** State **Kansas**

Sec. **25** (Blk. **17** (Sur. **10W** Map No.

Operator **Graham-Messman-Rinehart Oil Co.**

Well No. 1 Farm Becker

Elev.	Location	SE	SE	SW
-------	----------	----	----	----

FIRST REPORT

0

330 Ft. From S Line SW

350 Ft. From E Line Quarter

1st. Report OCT 17 1951

Completion

Remarks

Lohman & Johnson - Contr.

Spudding Date **10-11-51**

Drig. Data Heiken

8" @ 250' Drlg. 2440

OCT 19 1951

Scout Cards	
Land Small Map	
Land Wall Map	
Tracings	
France Map	
Pierce Map	
Misc	

Orig. Data

J. E. TYRA

Scout Cards m v
Land Small Map
Land Wail Map
Tracings
France Map
Pierce Map
Misc.....

DEC 14 1951

Orig. Date

J. G. McGEHEE

NOV 5 1953

Print Cards	<u>GW</u>
Land Small Map	
Land Wall Map	<u>BR</u>
Trails	
Franko Map	
Pierce Map	
Misc.	

Orig. Data