


Section 25 Township 17 Range 10W

Well No. #3 Becker

Company G - M - R Oil Company

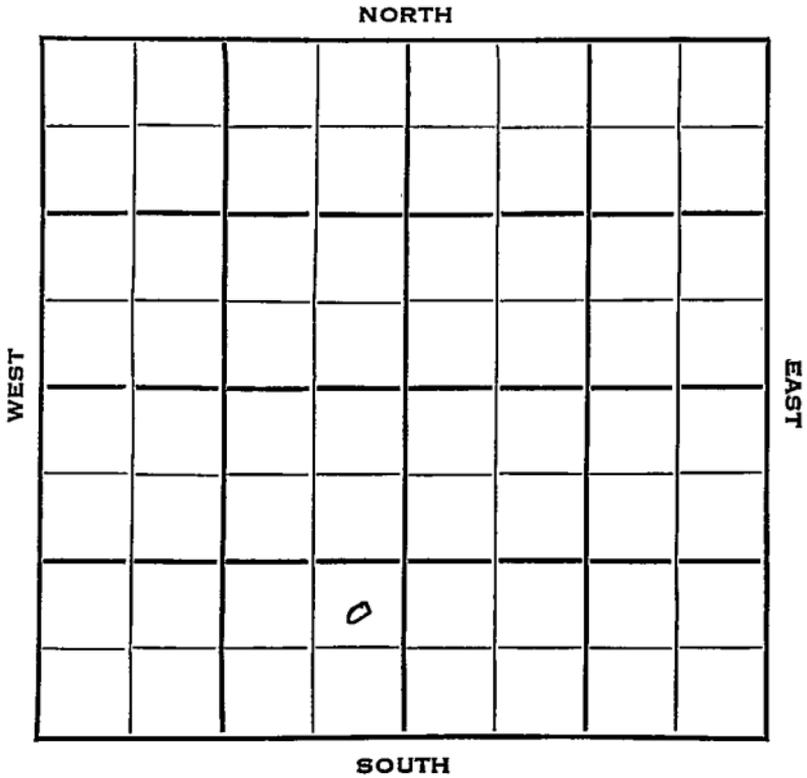

Sec. 25 Twp. 17 R. 10 W

Well No. # 3 Becker Farm _____

G-M-R Oil Company _____

G-M-R Contractor _____


_____ Ft. from N. Line

990 Ft. from S. Line

330 Ft. from E. Line

_____ Ft. from W. Line

NE SE SW

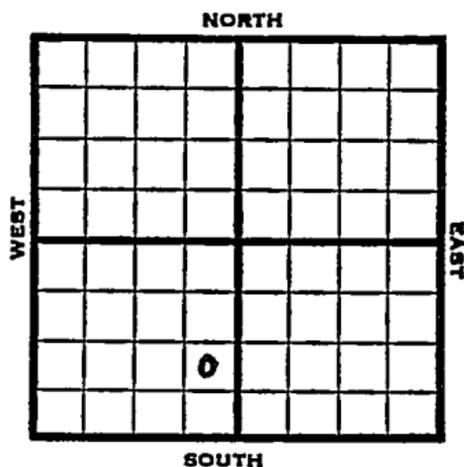

1953	Elev. 1781' REPORT
3/11	Spud 3-9-53 8" @ 180
3/19	Heeb 2773' Br li 2888' Lans 2907' Drlg. 3172'
3/26	Gong 3210, A Sd 3215-18 & 3227-31 DST 3194-3237, 40 mins., 500' muddy oil, FP 250 #, 560# Arb 3267, RTD 3273 5" @ 3270
4/2	NR
4/8	NR
4/16	Testing
4/23	"
4/30	"
5/7	"
5/13	Spud 3-9-53 Oil Well TD 3279' 8" @ 180' Heeb 2773, Br. Lime 2888', Lans 2907, Cong 3210, sd. 3215-18 3227-31. DST 3194-3237 opn 40 min, rec 500' muddy oil, 560# Arb 3267',

OVER

1953

Information brought forward.

5/13 TD 3273'
5" @ 3270'
DD 3279' HFW
PB 3261 2 1/4 / 3210-18 2 1/4 / 3221-29
2 1/4 / 3224-32 S / 5 boph P / 5 boph
Comp. 161 bopd 2% wtr.

COMPLETED

Scout Cards 22.72
Land Small Map.....
Land Wall Map 33
Tracings.....
France Map.....
Pierce Map.....
Etc.....

MAR 13 1953

Orig. Data

MAY 10 1954

Scout Cards	
Land & Small Map	
Land & Wall Map	
Tracings	5
France Map	
Pierce Map	
Misc	