

KANSAS

Ellsworth



Sec. 25 Twp. 17 R. 10W


Well No. #1 Stumps Farm

Hinkel et al Company

Stoltenberg Pool

NORTH

660' Ft. from N. Line

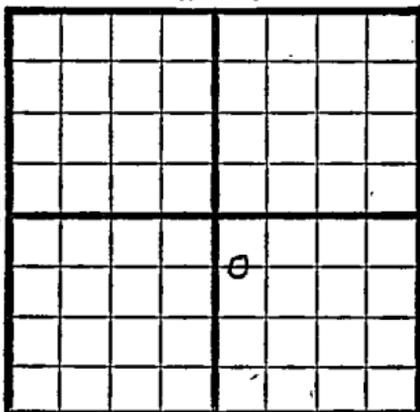

_____ Ft. from S. Line

_____ Ft. from E. Line

330' Ft. from W. Line

SOUTH

C W L NW SE

1948

Elev. 1775' REPORT

2/18

RUR

2/25

8" @ 214'

Drlg. 2192'

3/3

Arb. 3258'

Total Depth 3306'

ABANDONED

Map No. _____ Sec. 25 Twp. 17 R. 10W

Well No. 1 Stumps

Hinkel etal. _____ Company

FIRST REPORT _____ Contractor
C W L NW SE

SECTION PLAT

660 Ft. from N. Line

_____ Ft. from S. Line

_____ Ft. from E. Line

330 Ft. from W. Line

		o	

Ellsworth County

Location _____

Rig up _____

Drilling and Remarks:

R U R

RECORD

Cased _____ in., _____ ft.

Sand _____

Gas _____

Oil _____

Total Depth _____

PRODUCTION

1st 24 hrs. Nat. _____

1st 24 hrs. after shot _____

Gas _____ Cu. Ft.

Dry Hole _____

Abandoned _____

Date

FEB 18 1948 19

S. J. LEWIS Scout

Map No. 55 Sec. 25 Twp. 17 R. 10W

Well No. 1 Stumps

Hinkle etal. Company

ABANDONED Contractor

C W L NW SE

ELLIS
SECTION PLAT

660 Ft. from N. Line

_____ Ft. from S. Line

_____ Ft. from E. Line

330 Ft. from W. Line

		o	

Ellsworth County

Location _____

Rig up _____

Drilling and Remarks:

C. J. Lewis

RECORD

Cased _____ in., _____ ft.

Sand _____

Gas _____

Oil _____

Total Depth 3806

PRODUCTION

1st 24 hrs. Nat. _____

1st 24 hrs. after shot _____

Gas _____ Cu. Ft.

Dry Hole _____

Abandoned _____

Date

MAR 3 1948 19

S. J. LEWIS

Scout