

FORM 51


Ellsworth

KANSAS

Section 25 Township 17 Range 10W

Well No. 2 Stumps

Company Skelly Oil

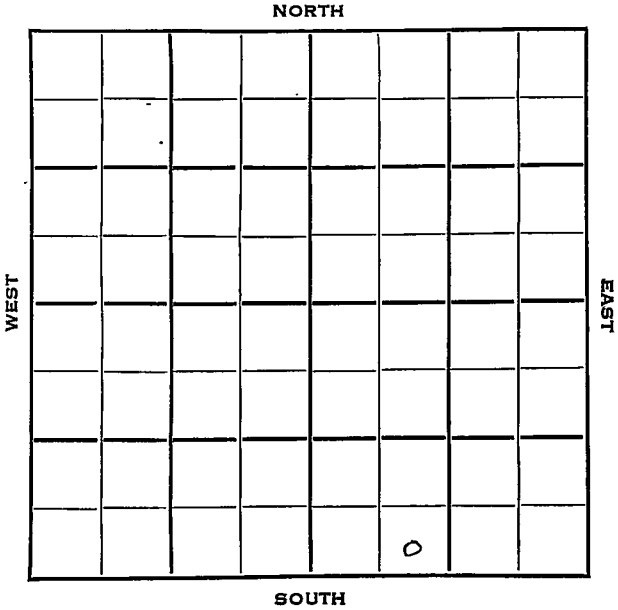

25

17

10W

Sec. \_\_\_\_\_ Twp. \_\_\_\_\_ R. \_\_\_\_\_

#2 Stumps

Well No. \_\_\_\_\_ Farm \_\_\_\_\_

Skelly Oil

Company \_\_\_\_\_


Contractor \_\_\_\_\_

\_\_\_\_\_ Ft. from N. Line

330 Ft. from S. Line

\_\_\_\_\_ Ft. from E. Line

990 Ft. from W. Line

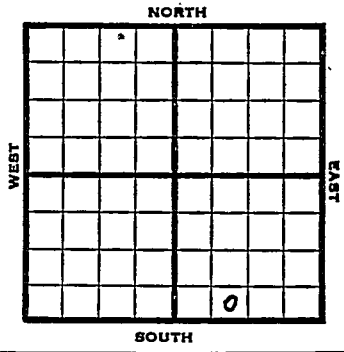

SE SW SE

1953 Elev. 1774' REPORT

- 1/21 Location
- 1/29 Drlg. 350'
- 2/5 8" @ 500  
Drlg. 2910'
- 2/12 Heeb 2775' Tor. 2794' Doug. 2806'  
Br. li 2891' Lans. 2908'  
DST 2979-96, 1/2 hr, gas in 5", 55' 0 &  
GCM, 180' G & MCO, 120' clean oil  
630#  
DST 2996-303, 1/4 hr, 40' SW 1109#  
Cong. 3208'  
DST 3203-39, 1/2 hr, 1760' oil,  
Arb. 3256' RTD 3258'  
5" @ 3258'
- 2/19 CO
- 2/26 DD 3273 TD  
B/15 goph 2 hrs., 500A  
B/20 go + 2 gwph  
PB 3234  
87/3215-31, S/95 BO 3 hrs.  
P/33 BO 3 hrs.

OVER

#2 Stumps

1953  
3/4

Spud 1-25-53

Oil Well

TD 3273

8" @ 500

Heeb 2775, Tor 2794, Doug 2806,  
Br lime 2891, Lans 2908

DST 2979-96, opn  $\frac{1}{2}$  hr., gas in  
5 mins., rec. 55' o & gcm, 180'  
g & mco, 120' clean oil 630#

DST 2996-3030, opn  $\frac{1}{4}$  hrs., rec.  
40' sw, 1109#

Cong 3208

DST 3203-39, opn  $\frac{1}{2}$  hr., rec.  
1760' oil

Arb 3256

TD 3258

5" @ 3258

DB 3273

B/15 goph 2 hrs., 500A.

B/20 go 2 bwph

PB 3234

87/3215-31, S/95 bo 3 hrs.

P/33 bo 3 hrs.

Comp. 1921 bopd

**COMPLETED**



JAN 26 1953

Scout Cards	112
Land Small Map	
Land Wall Map	5
Tracings	
France Map	
Pierce Map	
Misc.	



MAR 11 1953

Scout Cards	110
Land Small Map	
Land Wall Map	3
Tracings	
France Map	
Pierce Map	
Misc.	

Drig. Date