


Section 25 Township 17 Range 10 W

Well No. # 2 Stumps

Company Melvin Ochs et al

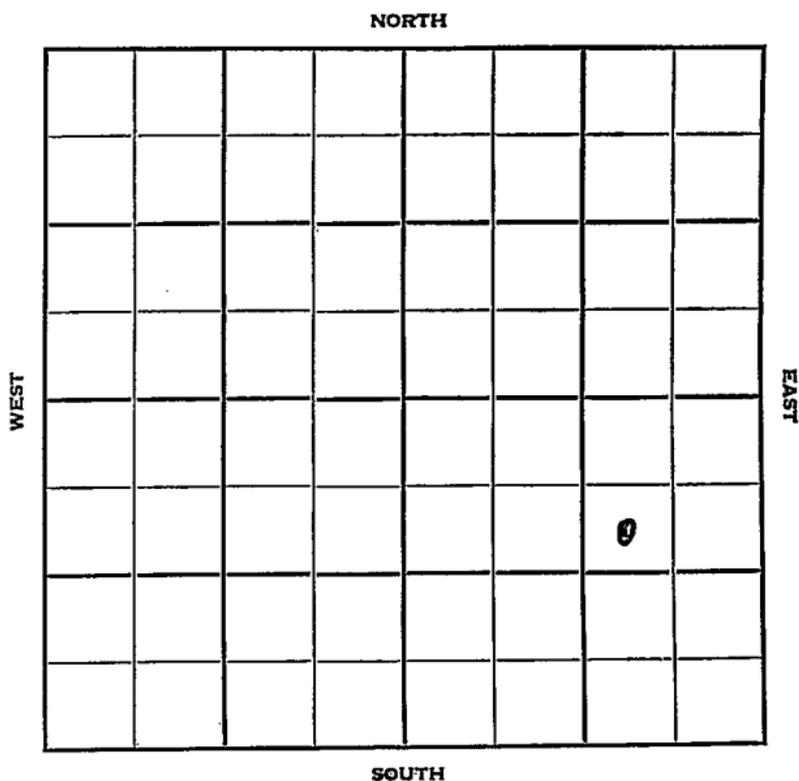

Sec. 25 Twp. 17 R. 10W

Well No. #2 Stumps Farm

Melvin Ochs et al Company

Trans Era Contractor


Heiken Pool

990 Ft. from N. Line

Ft. from S. Line

990 Ft. from E. Line

Ft. from W. Line

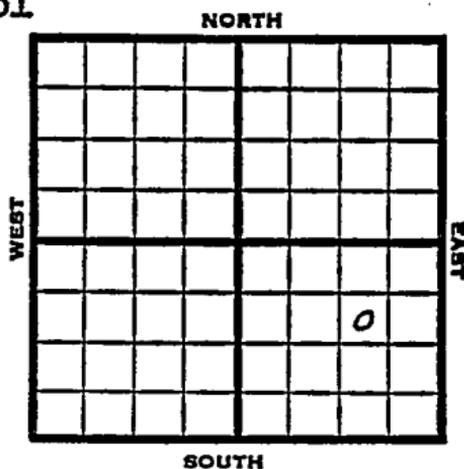

SW NE SE

1953 Elev. 1763' REPORT

6/24 Spud 6-16-53
8" @ 185'
Drlg 2750'

7/1 N.R.

7/29 Spud 6-16-53 Oil well TD 3278
8" @ 185' Heeb 2760 Br li 2878
Lans 2894
DST 2980-88 open 1/2 hr rec 10' mud &
SSO 1050# Cong. 3200 Arb. 3226
DST 3265-78 open 1 hr rec 660' sul
wtr.
DST 3186-3228 rec 300' O & GCM
TD 3278 5" @ 3277 Perf/3212-16
FU 300 oil 1/2 hr. B & S/5 BOPH 8 hr.
Comp. 185 BOPD

COMPLETED

