

Ellsworth KANSAS


DX 78-1

Section 25¹/₂ Township 17 Range 10W

Well No. 3 1/4 Stumps

Company Melvin Ochs

NORTH

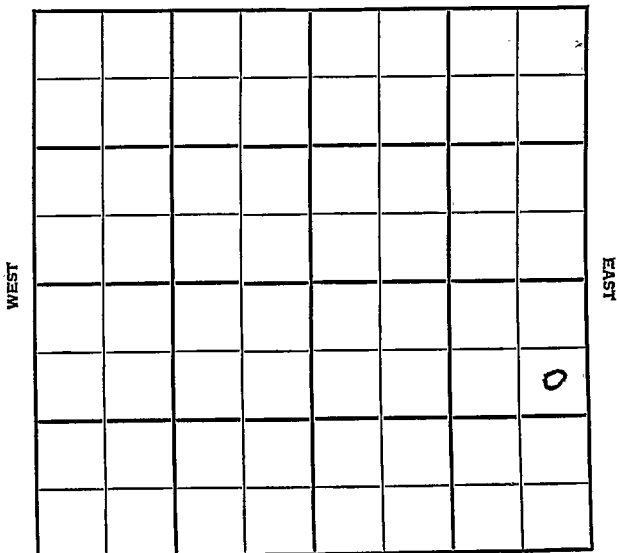

SOUTH

Ellsworth KANSAS

SEC. 25	TWP. 17	R. 10W
------------	------------	-----------

WELL NO. #3
Stumps FARM

COMPANY
Melvin Uchs


CONTRACTOR
T & E

Heiken Pool
990 Ft. from N. Line

Ft. from S. Line

330 Ft. from E. Line

Ft. from W. Line

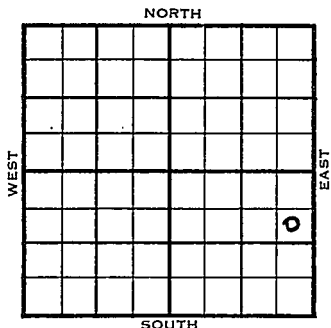

SE NE SE

1954	ELEVATION	REPORT
	1752	
11/7		Spdg 7-10-54 8" @ 186 Drlg. 1248.
7/21		Heeb 2753', Br li 2872', Lans 2889' DST 2913-21', 1 hr., 60' gas, 56' O&GCM, 95# Drlg. 3055'
7/28		Spdg 7-10-54 D&A TD 3245 8" @ 186 Heeb 2753 Br. Lime 2872 Lans. 2889 DST 2913-21 open 1 hr. Rec. 60' gas 56' o & gcm 95# Cong. 3205 Arb. 3230 TD 3245 DST 3178-3245 open 2 hr. Rec. 90' socm 555# D&A
		ABANDONED

Map No. _____ Sec. 25 Twp. 17 R. 10W

Well No. 3 Stumps

Melvin Ochs

Company

CORRECTION

Contractor

SE NE SE

SECTION PLAT

990 Ft. from N. Line

_____ Ft. from S. Line

330 Ft. from E. Line

_____ Ft. from W. Line

			?

Ellsworth County

Location _____

Rig up _____

Drilling and Remarks:

Reported
#4 Stumps

RECORD

Cased _____ in., _____ ft.

Sand _____

Gas _____

Oil _____

Total Depth _____

PRODUCTION

1st 24 hrs. Nat. _____

1st 24 hrs. after shot _____

Gas _____ Cu. Ft.

Dry Hole _____

Abandoned _____

Date

JUL 28 1954

J. G. MCGEHEE

Scout