


Section 25 Township 17 Range 10 W

Well No. # 5 J. Stumps

Company Skelly Oil

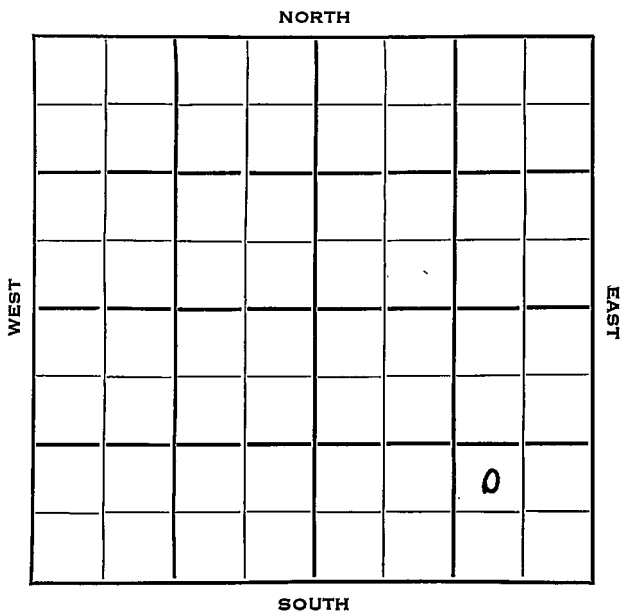

Sec. 25 Twp. 17 R. LOW

Well No. #5 J. Stumps Farm

Skelly Oil Company

Heiken Ppol Contractor


           Ft. from N. Line

990 Ft. from S. Line

990 Ft. from E. Line

           Ft. from W. Line

NW SE SE

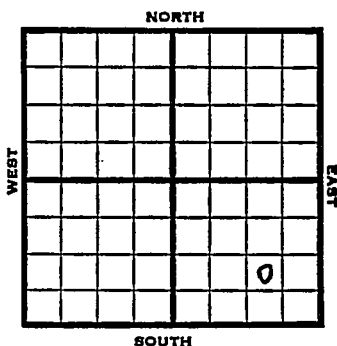

1953 Elev. 1753' REPORT

5/13 Spud 5-8-53  
8" @ 500, WOC

5/21 Drlg. 2750'  
5/28 Br. L. 2874, Lans 2890

DST 2907-77 1 hr, 15' Socm 25#  
Cong 3199, Arb 3233  
DST 3193-3240 1 hr, 545' HO&GCM, 180'  
muddy oil, 275#  
RTD 3270  
5" @ 3269'

6/3 CO 3265 25/ 3227-31 S/ 2 boph 2 hrs.  
106/ 3209-27 25/ 3202-06 S/ 213 BO  
20 hrs.

6/10 N.R.

6/24 Spud 5-8-53 Oil well TD 3270  
8" @ 500 Br. lime 2874' Lans 2890  
DST 2907-77 open 1 hr rec 15' SOCM  
25# Cong. 3199 Arb. 3233  
DST 3193-3240 open 1hr. rec 545' HO  
& GCM 180' muddy oil 275#  
TD 3270 5" @ 3269 CO to 3265  
25/3227-31 S/2 BOPH 106/3209-27  
25/3202-06 S/213 BO 20 hr.  
Comp. 232 BOPD

**COMPLETED**



