


FORM 51 5M 1-42 PETROL

Section 25 Township 17 Range 4-W

Well No. #2 Bear Estate

Company Winkler-Koch

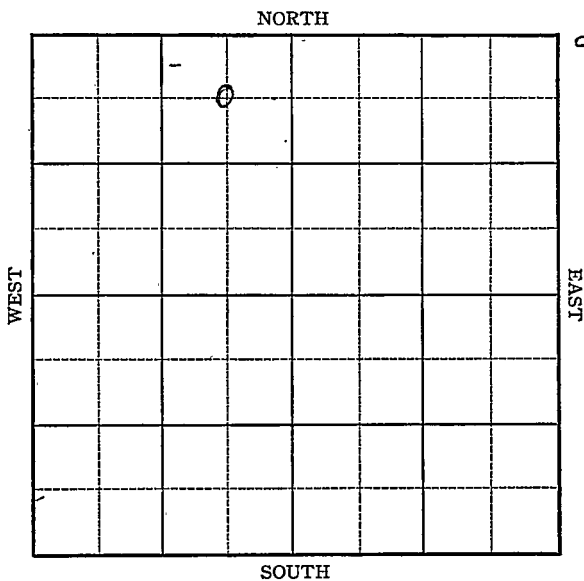

KANSAS

McPherson

Sec. 25 Twp. 17 R. 4-W

Well No. #2 Bean Estate Farm

Winkler-Koch Company


660 Ft. from N. Line

 Ft. from S. Line

660 Ft. from E. Line

 Ft. from W. Line

elev. 1353

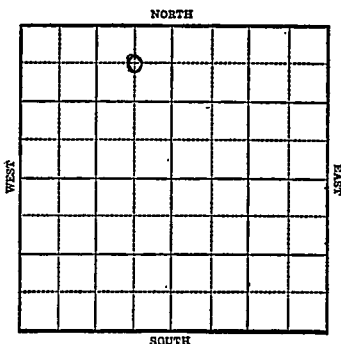

1943

R E P O R T

5/19 Rotary
5/26 15" @ 180' WOC.
6/2 10" @ 385
Drlg. 1410
6/9 Miss 2975
Drlg. 3010
6/16 Viola 3395-98 T.D. SS0
7" @ 3397' Rust
6/23 " " "
6/30 T.D. 3405-1700' oil 2 hrs.
7/7 Viola 3395
7" @ 3397'
T.D. 3405'
500 acid
Echo Pot 5193
Max 3000
Gravity 36

COMPLETED

KANSAS

McPherson

Map No. 44 Sec. 25 Twp. 17 R. 4WWell No. 2 Bean Estate

Winkler-Koch

Company

FIRST REPORT

Contractor

C NE NW

SECTION PLAT

	o		

660 Ft. from N. Line Ft. from S. Line660 Ft. from E. Line Ft. from W. Line

LINDSBORG POOL

Location Rig up

Drilling and Remarks:

Rotary

RECORD

Cased in., ft.Sand Gas Oil Total Depth

PRODUCTION

1st 24 hrs. Nat. 1st 24 hrs. after shot Gas Cu. Ft. Dry Hole Abandoned

Date

MAY 19 1943

19

S. J. LEWIS

Scout

KANSAS McPherson

Map No. 44 Sec. 25 Twp. 17 R. 4WWell No. 2 Bean Estate

Winkler-Koch

Company

COMPLETED

Contractor

C NE NW

SECTION PLAT

660 Ft. from N. Line

Ft. from S. Line

660 Ft. from E. Line

Ft. from W. Line

LINDSBORG POOL

Location

Rig up

Drilling and Remarks:

*Vida 3395**7" @ 3397**500 acid**Ech 18 5193**Max 3000**36 2 Gr*

RECORD

Cased _____ in., _____ ft.

Sand _____

Gas _____

Oil _____

Total Depth 3425

PRODUCTION

1st 24 hrs. Nat. _____

1st 24 hrs. after shot _____

Gas _____ Cu. Ft.

Dry Hole _____

Abandoned _____

Date

JUL 7 1943

19

S. J. LEWIS Scout