

KANSAS


McPherson

FORM 51 5M 1-42 PETROL

Section 25 Township 17 Range 4-W

Well No. #5 Bergstrom

Company Auto Ordnance

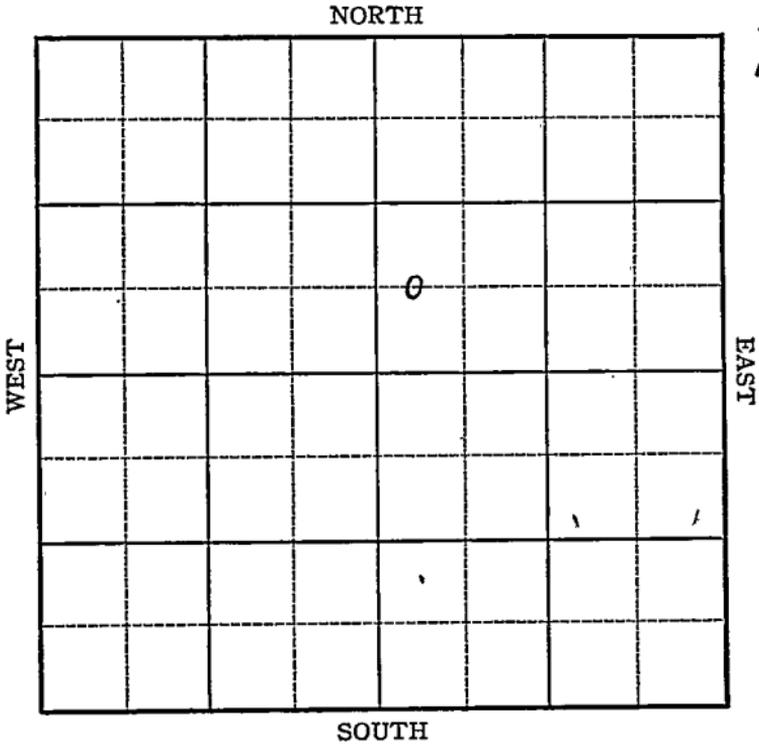

KANSAS

McPherson

Sec. 25 Twp. 17 R. 4-W

Well No. #5 Bergstrom Farm

Auto Ordnance Company


Lindsborg

_____ Ft. from N. Line

_____ Ft. from S. Line

_____ Ft. from E. Line

_____ Ft. from W. Line

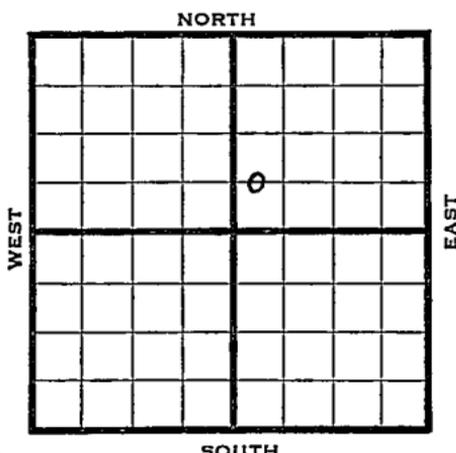

C WL SW NE *El. 1349*

SOUTH

1943

REPORT

1/27 Location.

2/3 176 fsg.

2/10 15" @ 168'

10" @ 372'

Drlg. 900'

2/17 Miss 2936

Drlg. 2976

2/24 Viola 3384

TD 3386

5" Casing set 3384 RUST.

3/3 " " " "

3/10 TD 3394

Swab 67 bbls oil Temp Pot.

3/16 PB 3389 $\frac{1}{2}$ swb 25 oil in 3 hrs.

3/24 Viola 3384

5" @ 3384'

T.D. 3394'

P.B. 3389 $\frac{1}{2}$ '

4500 gal. acid.

Echo Pot. 1742

Gravity 36

COMPLETED

McPherson

Map No. KANSAS Sec. 25 Twp. 17 R. 4WWell No. 5 BergstromAuto Ordnance

Company

FIRST REPORT

Contractor

C WL SW NE

SECTION PLAT

_____ Ft. from N. Line

660 Ft. from S. Line

_____ Ft. from E. Line

330 Ft. from W. Line

		o	

LINDSBORG POOL

Location XXX

Rig up _____

Drilling and Remarks:

RECORD

-Cased _____ in., _____ ft.

Sand _____

Gas _____

Oil _____

Total Depth _____

PRODUCTION

1st 24 hrs. Nat. _____

1st 24 hrs. after shot _____

Gas _____ Cu. Ft.

Dry Hole _____

Abandoned _____

Date

JAN 27 1943 19S. J. LEWIS Scout

KANSAS
 Map No. 94 Sec. 25 Twp. 17 R. 4W

Well No. 5 Bergstrom

Auto Ordnance Company

COMPLETED

Contractor

C WL SW NE

SECTION PLAT

_____ Ft. from N. Line

660 Ft. from S. Line

_____ Ft. from E. Line

330 Ft. from W. Line

		o	

LINDSBORG POOL

Location _____

Rig up _____

Drilling and Remarks:

Vista 3384
5 @ 3384
PB 3389 1/2
4500 cu ft
Ech Pot. 1742
36° G

RECORD

Cased _____ in., _____ ft.

Sand _____

Gas _____

Oil _____

Total Depth 3384

PRODUCTION

1st 24 hrs. Nat. _____

1st 24 hrs. after shot _____

Gas _____ Cu. Ft.

Dry Hole _____

Abandoned _____

Date

MAR 24 1943 19

S. J. LEWIS Scout