


Section 25 Township 17 Range 4-W

Well No. #2 Hoffman

Company Vickers.

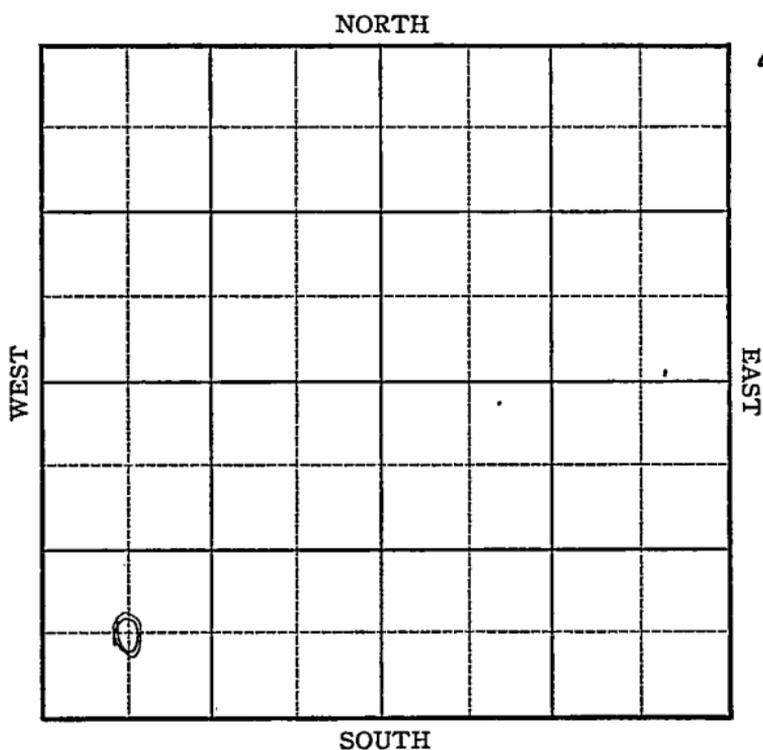

13

KANSAS

McPherson

Sec. 25 Twp. 17 R. 4 ~~W~~

Well No. #2 Hoffman Farm

Vickers Company


Lindsborg

 Ft. from N. Line

660 Ft. from S. Line

 Ft. from E. Line

660 Ft. from W. Line

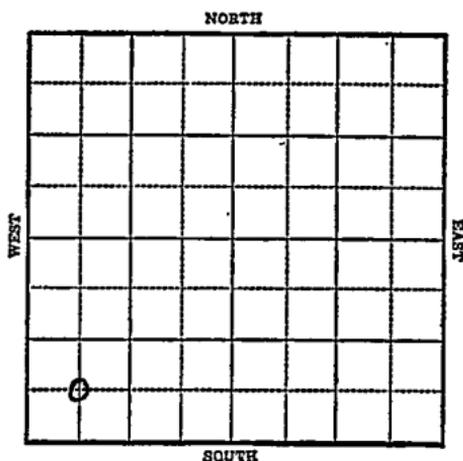

1943

R E P O R T

5/12 Location.
5/19 Derrick
5/26 12" @ 176
Drlg. 250
6/2 8" @ 395
Drlg. 2100'
6/9 miss 2988
Drlg. 3275
6/16 Viola 3442
T.D. 3450'
No shows.

ABANDONED

KANSAS

McPherson

Map No. 44 Sec. 25 Twp. 17 R. 4W

Well No. 2 Hoffman

Vickers Company

FIRST REPORT Contractor

C S W S W

SECTION PLAT

o			

_____ Ft. from N. Line

660 Ft. from S. Line

_____ Ft. from E. Line

660 Ft. from W. Line

LINDSBORG POOL

Location XXX

Rig up _____

Drilling and Remarks:

RECORD

Cased _____ in., _____ ft.

Sand _____

Gas _____

Oil _____

Total Depth _____

PRODUCTION:

1st 24 hrs. Nat. _____

1st 24 hrs. after shot _____

Gas _____ Cu. Ft.

Dry Hole _____

Abandoned _____

Date

MAY 12 1943 19

S. J. LEWIS Scout

McPherson

KANSAS

Map No. 44 Sec. 25 Twp. 17 R. 4WWell No. 2 HoffmanVickers

Company

ABANDONED

Contractor,

C S W S W

SECTION PLAT

_____ Ft. from N. Line

660 Ft. from S. Line

_____ Ft. from E. Line

660 Ft. from W. Line

o			

LINDSBORG POOL

Location _____

Rig up _____

Drilling and Remarks:

*Viola 3442**No show*

RECORD-

Cased _____ in., _____ ft.

Sand _____

Gas _____

Oil _____

Total Depth 3450

PRODUCTION

1st 24 hrs. Nat. _____

1st 24 hrs. after shot _____

Gas _____ Cu. Ft.

Dry Hole _____

Abandoned _____

Date

JUN 16 1943 19

S. J. LEWIS Scout