


Section 25 Township 17 Range 8W

Well No. #2 Janssen

Company El Dorado Refg.

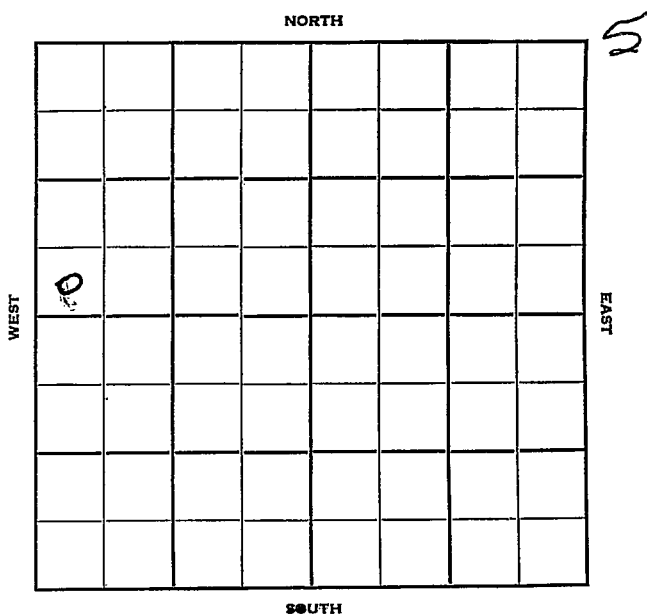

Sec. 25 Twp. 17 R. 8W

Well No. #2 Janssen Farm

El Dorado Refg. Company

Maes Contractor


 Ft. from N. Line

330' Ft. from S. Line

 Ft. from E. Line

330' Ft. from W. Line

SW SW NW

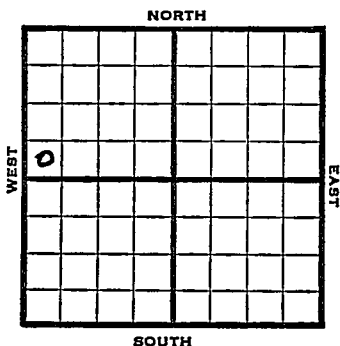

1952

Elev. 1750' REPORT

7/2

Location

7/9

8" @ 318
Drlg. 2810'

7/17

Heeb. 2647 Dodge 2675
Br Li 2772 Lans. 2798
DST 2821-33 1/2 hr. 30' M 900#
Arb. 3293-96 RTD

5" @ 3295 DD 3299 fill up 3000'
oil 24 hrs. DD

7/23

DD 3302 TD fill up 3100' oil
S/ 4l Boph POP

7/30

NR

8/6

Spud 7-1-52
Oil well TD 3302' 8" @ 318
Heeb 2647' Dodge 2675' Br. li 2772'
Lans. 2798'
DST 2821-33 open 1/2 hr. rec 30' mud
900# Arb. 3293' 5" @ 3295 TD 3296'
DD 3299' FU 3000' oil 24 hr.
DD 3302' FU 3100' oil S/4l BOPH
3 1/2 hr. Comp. 3000 BOPD

COMPLETED

County Ellsworth State Kansas
 Sec. 25 (Blk. 17) (Sur. 8W) (Twp.) (Rge.) Map No.
 Operator Eldorado Ref.
 Well No. 2 Farm Janssen
 Elev. 1750 Location SW SW NW

0							

330 Ft. From S Line NW
 330 Ft. From W Line Quarter

1st. Report

Completion AUG 6 1952

Remarks Maes Pool

Spudding Date 7-1-52

Drlg. Data Oil well TD 3302

8" @ 318 Heeb. 2647 Dodge 2675

Br. lime 2772 Lans. 2798 DST 2821-33

open $\frac{1}{2}$ hr. Rec. 30' mud 900#

Arb. 3293 5" @ 3295 TD 3296

DD 3299 FU 3000' oil 24 hr. DD 3302

FU 3100' oil S/ 41 boph $3\frac{1}{2}$ hr.

Comp. 3000 bopd