


Section 25 Township 17 Range 8W
Well No. #4 Janssen
Company Eldorado Ref.

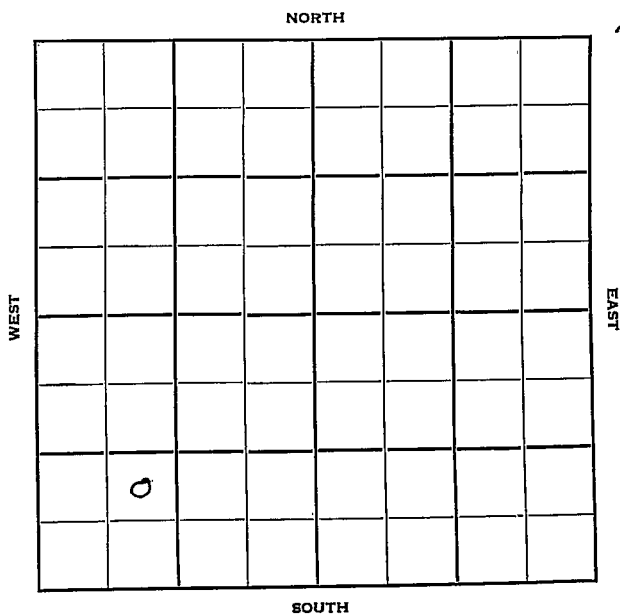

Ellsworth

KANSAS

Sec. 25 Twp. 17 R. 8WWell No. #4 Janssen FarmElDorado Ref. CompanyCarey Drlg. ContractorMaes Pool


Ft. from N. Line

990 Ft. from S. Line

Ft. from E. Line

990 Ft. from W. Line

NE SW SW

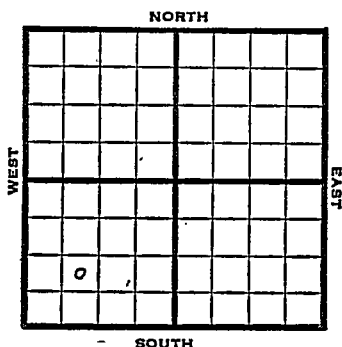

1952 Elev 1757 REPORT

10/1 MIR

10/8 8" @ 305,
Lans 2807'10/15 Arb 3326-28 TD
5" @ 3326'10/22 Heeb 2662', Br Li 2783', Lans 2807',
Marm 3139', V. 3219', Simp 3265'
(Arb 3323', RTD 3325, 5" @ 3324) -
Cor)DD 3329 TD fill up 325' oil & 325'
wtr 12 hrs., S/23 BW & 6 BOPH for
4 hrs., 1800' off BtmPB 3324 12/3323-24 500 A S/60 BO
& 120 BW 3 hrs., 1900' off Btm

10/29 NR

11/5 "

11/12 "

11/20 "

11/27 "

12/3 Spud 10-1-52
Oil Well
TD 3329'
8" @ 305

OVER

(Information Brought Forward)

1952

12/3

Heeb. 2662; Br. lime 2783,
Lans 2807, Marm. 3139, Viola
3219', Simp 3265, Arb. 3323,
TD 3325
5" @ 3324
DD 3329, FU 325' oil 325' wtr.
12 hrs., S/23 bw 6 boph 4 hrs.
PB 3324, 12/3323-24, 500A
S/60 bo 120 bw 3 hrs.
Comp. 228 bopd 72% wt.r


COMPLETED

J. G. McGEHEE

Scout Cards	A. D.
Land Small Map	
Land Vail Map	5
Land Map	
Pierce Map	
Misc.	

OCT 3 1952

County Ellsworth State Kansas
 Sec. 25 (Blk.) 17 (Sur.) 8W Map No.
 Operator Eldorado Ref.
 Well No. 4 Farm Janssen
 Elev. 1757 Location NE SW SW

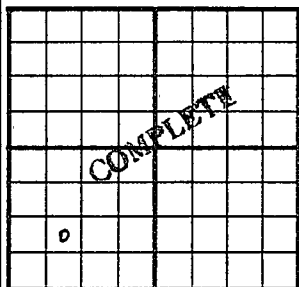

990 Ft. From S Line SW
990 Ft. From W Line Quarter
 Ist. Report
 Completion DEC 3 1952
 Remarks Maes Pool
Carey Drlg. - Contr.
 Spudding Date 10-1-52

Drlg. Data Oil well TD 3329
8" @ 305 Heeb. 2662 Br. lime 2783
Lans. 2807 Marm. 3139 Viola 3219
Simp. 3265 Arb. 3323 TD 3325
5" @ 3324 DD 3329 FU 325' oil 325' wtr.
12 hr. S/ 23 bw 6 boph 4 hr. PB 3324
12/ 3323-24 500 A. S/ 60 bo 120 bw 3 hr
Comp. 228 $\frac{1}{2}$ bopd - 72% wtr.

Scout Cards	
Land Small Map	
Land Wall Map	
Tracings	
France Map	
Pierce Map	
Misc.	

DEC 10 1952